


CERTIFIED RECORD OF LAND CORNER MONUMENTATION

Index File No. 0-12

History of original corner establishment:

NOT SET

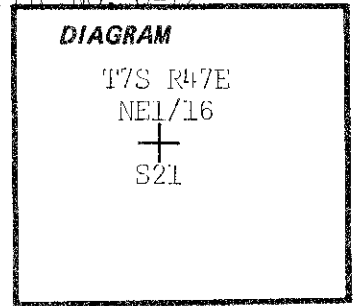

Description of corner evidence found:

NONE

Description of monument and accessories established to perpetuate the original location of this corner:

At the center of the surveyed point, set 2 1/2" X 30" galvanized pipe and brass cap marked: Set pipe 22" in the ground and mound of stone around to cap.

From which by magnetic declination of N20°E:

A 14" pine bears S63°E, 315.7 ft. scribed NE1/16S21 BT.

A 21" pine bears S50°W, 254.7 ft. scribed NE1/16S21 BT.

Painted blazes red and 6" red band around. Placed 54-3s, 54-9s, and brass washers stamped PLS 1051 on the BTs. Placed 54-2 and 54-9 on a steel fence post 5' south and placed 54-2 on a steel fence post 5' east of the corner.

T7S R47E
NE1/16
+
S21
OR PLS 1051
1981

I hereby certify that the above corner monument was established as herein described.

Witnesses: David Cummins
Daniel Rowlands
Douglas Moser

February 20, 1981

**REGISTERED
PROFESSIONAL
LAND SURVEYOR**

Barry B. Barbour
OREGON
OCT. 17, 1975
BARRY B. BARBOUR
1031

Office of..... County Surveyor..... County of..... Baker.....
State of....., I hereby certify that the within instrument was filed in this office
for record on the..... day of....., 19.81.
..... by *Thomas G. Henry*.....
(COUNTY OFFICIAL) (DEPUTY)

FILED July 27, 1981
BAKER COUNTY SURVEYOR
SURVEY NO. 7-47-29