

CERTIFIED RECORD OF LAND CORNER MONUMENTATION

Index File No. P-3


DIAGRAM

T7S R47E

CL/4 - S19

History of original corner establishment:

Not set.

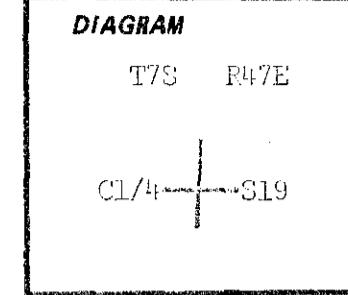

Description of corner evidence found:

None

Description of monument and accessories I established to perpetuate the original location of this corner:

At survey point, set 2 1/2" x 30" galvanized pipe and brass cap marked as shown.

T7S R47E


Set pipe 26" in the ground and mound of stone around to cap. Built mound of stone 3 ft. in diameter and 2 ft. high, 5 ft. west of the corner. No BTs marked due to being on private property and owner not wanting his trees used. Placed 54-9 on a steel fence post 5 ft. east of the corner.

CL/4 - S19
OR PLS 1051
1981

I hereby certify that the above corner monument was established as herein described.

Witnesses: Daniel Rowland
Beverly Weaselhead

June 2, 1981

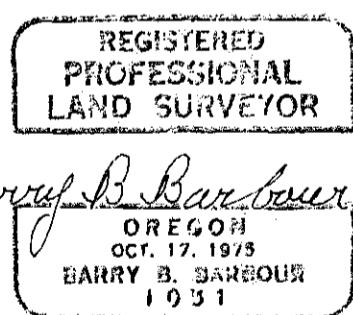

Office of..... County Surveyor..... County of..... Baker

State of..... Oregon....., I hereby certify that the within instrument was filed in this office for record on the..... day of..... June 81

..... by (Clerk, Sheriff, Notary Public, etc.)
(COUNTY OFFICIAL) (DEPUTY)

Form R6-7100-57 (9/71)

★ GPO—798-276

FILED June 27, 1981
BAKER COUNTY SURVEYOR
SURVEY NO. 7-47-31