


CERTIFIED RECORD OF LAND CORNER MONUMENTATION

Index File No. P-9

History of original corner establishment:

Corner was originally established under G. L. O. contact number 707, by Williard B. Blakeslee on June 15, 1901. Surveyor General's notes state: "Set a basalt stone, 12 X 8 X 8 ins., in the ground for 1/4 sec., corner marked 1/4S on the W. face, raised mound of stone 3 ft. base 24 ins. high 10 lks. W. of the corner. (Pit Imp)"

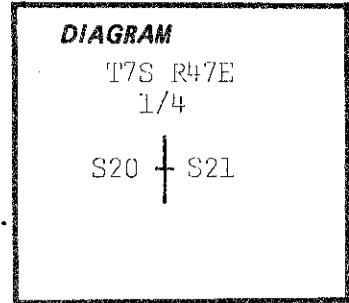


Description of corner evidence found:

Found 13 X 10 X 8 inch stone set in mound of stone, plainly marked 1/4S. on W. face. Found remains of mound of stone 10 lks. W.

Description of monument and accessories established to perpetuate the original location of this corner:

At the center of the above point, set 2 1/2" X 30" galvanized pipe and brass cap marked: Set pipe 24" in the ground and mound of stone around to cap. Buried marked stone alongside of the pipe.

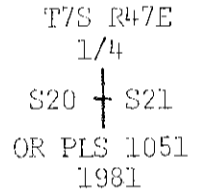

From which by magnetic declination of N20°E:  
A 27" pine bears S55°E, 186.6 ft, scribed 1/4S21 BT. No other trees available. Painted blazes red and 6" red band around. Placed 54-3S, 54-4S, and brass washers stamped PLS 1051 on the BTs. Placed 54-4 on a steel fence post 5' north and raised a mound of stone 3 ft. base, 3 ft. high 5 ft. west of the corner.

I hereby certify that the above corner monument was reestablished as herein described.

Witnesses: David Cummins  
Daniel Rowland  
Douglas Moser

January 27, 1981

REGISTERED  
PROFESSIONAL  
LAND SURVEYOR

*Barry B. Barbour*  
OREGON  
OCT. 17, 1979  
BARRY B. BARBOUR  
1051

Office of.....County..Surveyor..... County of...Baker.....  
State of....., I hereby certify that the within instrument was filed in this office  
for record on the..... day of....., 19.81  
..... by .....  
(COUNTY OFFICIAL) (DEPUTY)

FILED July 27, 1981  
BAKER COUNTY SURVEYOR  
SURVEY NO. 7-47-34