


CERTIFIED RECORD OF LAND CORNER MONUMENTATION

Index File No. R-2

History of original corner establishment:

Not set.

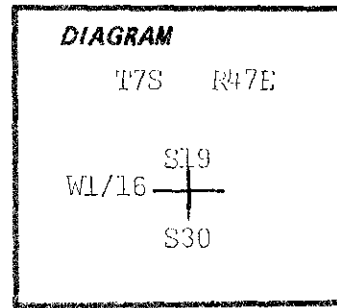

Description of corner evidence found:


Found 1/2" rebar that was used for temporary corner during survey.

Description of monument and accessories I established to perpetuate the original location of this corner:

At the center of surveyed point, set 2 1/2" x 30" galvanized pipe and brass cap marked as shown. Set pipe 23" in the ground and mound of stone around to cap. No trees. Built 3 ft. x 3 ft. mound of stone 5 ft. north of the corner.

Placed 54-2 and 54-9 on a steel fence post 5 ft. west and placed 4-2 on a steel fence post 5 ft. north of the corner.

T7S R47E

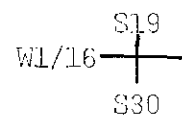

OR PLS 1051

1981

I hereby certify that the above corner monument was established as herein described.

Witnesses: David Cummins
Daniel Rowland
Douglas Moser
Brian Cays

April 24, 1981

REGISTERED
PROFESSIONAL
LAND SURVEYOR

OREGON
OCT. 17, 1975
BARRY B. BARBOUR
1981

Office of..... County Surveyor..... County of..... Baker.....
State of..... Oregon....., I hereby certify that the within instrument was filed in this office