


CERTIFIED RECORD OF LAND CORNER MONUMENTATION

Index File No. R-3

History of original corner establishment:

Corner was originally established under G. L. O. contract number 707, by Williard B. Blakeslee on August 2, 1901. Surveyor General's notes state: "Set a lava stone 16 X 12 X 4 ins. in the grnd, for 1/4 sec. cor. marked 1/4S on N. face, raised a mound of stone 3 ft. base 24 ins high 10 lks. N. of the cor. (Pits Imp.)."

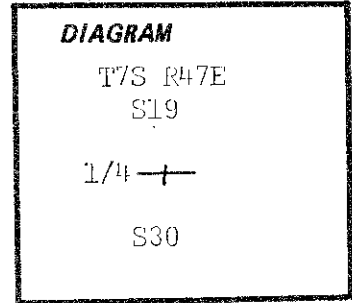

Description of corner evidence found:

Found 15 X 11 X 4 inch stone, firmly set and projecting 6" above the ground, marked 1/4S on the north face. Large mound of stone 5' north of the corner. Corner is 10 ft. east of small drain.

Description of monument and accessories established to perpetuate the original location of this corner:


At the center of the above point, set 2 1/2" X 30" galvanized pipe and brass cap marked: Set pipe 24" in the ground and mound of stone around to cap. Buried marked stone alongside of the pipe.
No Trees in the area.
Placed 54-4 on a steel fence post 5' east of the corner.

T7S R47E
S19
1/4 —+
S30
OR PLS 1051
1980

I hereby certify that the above corner monument was reestablished as herein described.

Witnesses: Daniel Rowland

November 25, 1980

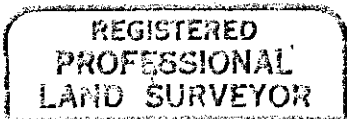

Barry B. Bangour
 OREGON
 OCT. 17, 1975
 BARRY B. BANGOUR
 1051

Office of..... County Surveyor..... County of..... Baker.....
 State of....., I hereby certify that the within instrument was filed in this office
 for record on the..... day of....., 19⁸¹
 by *Thomas J. Henry*.....
 (COUNTY OFFICIAL) (DEPUTY)

FILED July 27, 1981
 BAKER COUNTY SURVEYOR
 SURVEY NO. 7-47-40