


CERTIFIED RECORD OF LAND CORNER MONUMENTATION

Index File No. R-5

History of original corner establishment:

Corner was originally established under GLO contract number 707, by Williard B. Blakeslee on June 18, 1901. Surveyor General's notes state: "Set a basalt stone 16 x 12 x 10 ins., 10 ins. in the grnd. for cor. to Secs. 19, 20, 29 & 30, marked with 2 notches on the S. and 5 on the E. faces. Raised a mound of stone 3 ft. base 24 ins. high 10 lks. W. of the corner."

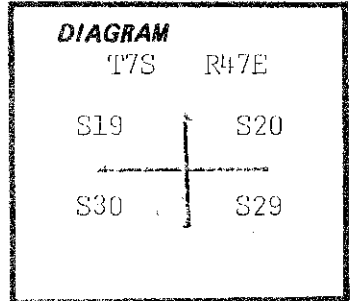

Description of corner evidence found:

Found no trace of record stone or mound of stone. Corner falls 8.5 ft. north of a "T" fence corner bearing south and east-west. Large rock jack at fence corner.

Description of monument and accessories established to perpetuate the original location of this corner:

At the center of surveyed point, set 2 1/2" x 30" galvanized pipe and brass cap marked as shown. Set pipe 21" in the ground and mound of stone around to cap. No trees. Placed 54-2 and 54-4 on a steel fence post 5' east and placed 54-2 on a steel fence post 5' west of the corner. Built 2' x 3' mound of stone 5' west of the corner.


T7S	R47E
S19	S20
S30	S29

OR PLS 1051
1981

I hereby certify that the above corner monument was reestablished as herein described.

Witnesses: Douglas Moser

April 22, 1981

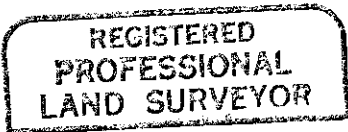

Barry B. Bardgur
OREGON
OCC. 17, 1973
BARRY B. BARDGUR
1051

Office of... County Surveyor..... County of... Baker.....
State of... Oregon....., I hereby certify that the within instrument was filed in this office
for record on the..... day of..... June....., 19..... 81
..... by *Thomas J. Hendry*.....
(COUNTY OFFICIAL) (DEPUTY)

FILED July 27, 1981
BAKER COUNTY CLERK
SURVEY NO. 7-47-42