


**CERTIFIED RECORD OF LAND CORNER MONUMENTATION**

Index File No. T-17

**History of original corner establishment:**

Corner was originally established under G. L. O. contract number 707, by Williard B. Blakeslee on June 7, 1901. Surveyor General's notes state: "Set lava stone 18 X 12 X 6 ins, 12 ins. in the grnd. for 1/4 Sec. Cor., marked 1/4S on the W. face, from which a pine tree 22 ins. in diam. brs. N40°E, 60 lks. dist. marked 1/4S26 BT. and a pine 16 ins. in diam. bears N17°W, 104 lks., dist., marked 1/4S27 BT."

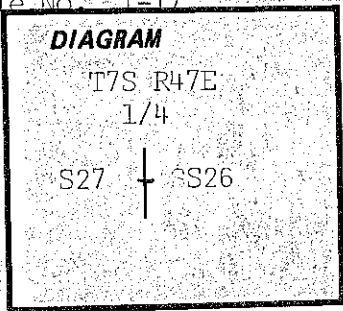

**Description of corner evidence found:**

Found a Lava stone 18 X 12 X 6 inches projecting 8 inches out of the ground with prominent 1/4S. scribed on the west face. Found live and in good condition a 40" pine with healed over blaze bearing N45°E, 39.6 ft. distance and a 30" pine with blaze and visible but (unclear) scribing bearing N17°W, 77.1 ft. distance. (Accepted Stone)

**Description of monument and accessories I established to perpetuate the original location of this corner:**

At the center of the above point, set 2 1/2" X 30" galvanized pipe and brass cap marked: Set pipe 24" in the ground and mound of stone around to cap. Buried marked stone alongside of the pipe.

T7S R47E  
1/4  
S27 | S26  
OR PLS 1051  
1981

From which by magnetic declination of N20°E:  
Improved existing live BTs with paint and proper signs.  
Painted blazes red and 6" red band around. Placed 54-3s, 54-4s on the BTs.  
Placed 54-4 on a steel fence post 5' west.

I hereby certify that the above corner monument was reestablished as herein described.

Witnesses: David Cummins  
Daniel Rowland  
Douglas Moser

February 19, 1981

**REGISTERED  
PROFESSIONAL  
LAND SURVEYOR**

*Barry B. Barbour*  
OREGON  
OCT. 17, 1975  
BARRY B. BARBOUR  
1031

Office of.....County Surveyor..... County of Baker.....  
State of..... I hereby certify that the within instrument was filed in this office  
for record on the..... day of....., 19..81  
..... by *Thomas J. Hendley*.....  
(COUNTY OFFICIAL) (DEPUTY)

FILED July 27, 1981  
BAKER COUNTY SURVEYOR  
SURVEY NO. 7-47-50