


CERTIFIED RECORD OF LAND CORNER MONUMENTATION

Index File No. **Z-1**

History of original corner establishment:

Corner was originally established under GLO contract number 443 by W. B. Barr on September 9, 1882. Surveyor General's notes state: "Set granite stone 14 x 10 x 9 inches, 8 ins. in the grnd. marked with 6 notches on N. S. E. and W. edges. Built mound of stone alongside."

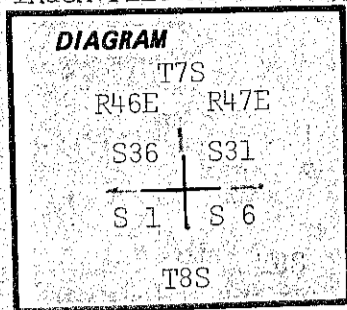

Description of corner evidence found:

Found 14 x 10 x 9 inch stone, firmly set 8 inches in the ground. Found 6 notches on one side, and 2 notches on two other sides. Rock is partially broken on top.


Description of monument and accessories established to perpetuate the original location of this corner:

At the center of the above point, set 2 1/2" x 30" galvanized pipe and brass cap marked as shown. Set pipe 24" in the ground and mound of stone around to cap. Buried marked stone alongside of the pipe.

No trees in the area.

Rebuilt old mound of stone 5 ft. west of corner, 2 ft. high and 3 ft. base.

Placed 54-4 on a steel fence post 5 ft. north of the corner.

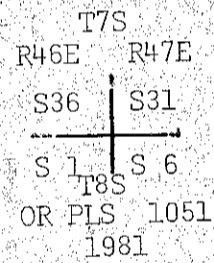

I hereby certify that the above corner monument was reestablished as herein described.

Witness: Douglas Moser

April 14, 1981

**REGISTERED
PROFESSIONAL
LAND SURVEYOR**

Barry B. Barbour

OREGON
OCT. 17, 1975
BARRY B. BARBOUR
1031

Office of.....County Surveyor..... County of "Baker"
State of Oregon..... I hereby certify that the within instrument was filed in this office
for record on the..... day of..... June..... 19..... 81
..... by *Thomas J. Hendley*
(COUNTY OFFICIAL) (DEPUTY)

FILED July 27, 1981
BAKER COUNTY SURVEYOR
SURVEY NO. 7-47-51