


CERTIFIED RECORD OF LAND CORNER MONUMENTATION

File Index No. Z-5

History of original corner establishment:

Corner was originally established under G. L. O. contract number 443, by W. B. Barr on Sept. 9, 1882. Surveyor General's notes state: "Set a basalt rock 14 x 11 x 8 ins., 9 inches in ground for corner to secs. 5, 6, 31 and 32, marked with 5 notches on the east and 1 notch on the west sides. Raised a mound of rock alongside."

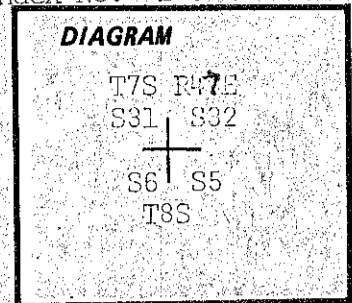


Description of corner evidence found:

Found no trace of record stone or mound. Corner falls 35 ft. west of a north-south fence with large rock jacks.

Description of monument and accessories established to perpetuate the original location of this corner:

At the center of surveyed point, set 2 1/2" x 30" galvanized pipe and brass cap marked: Set pipe 14" in the ground and mound of stone around to cap. No trees. Built 2' x 3' mound of stone 5' west of the corner. Painted blazes red and 6" red band around. Placed 54-3s, 54-4s, 54-9s, and brass washers stamped PLS 1051 on the BTs. Placed 54-4 on a steel fence post 5' east of the corner.

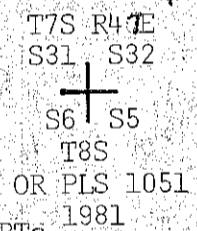

BBB

I hereby certify that the above corner monument was reestablished as herein dexcribed.

Witnesses: Daniel Rwoland

April 24, 1981

REGISTERED PROFESSIONAL LAND SURVEYOR

Signature of Barry B. Barbour, OREGON OCT. 17, 1975 BARRY B. BARBOUR 1051

Office of County Surveyor County of Baker State of Oregon I hereby certify that the within instrument was filed in this office for record on the day of 19 81 by Thomas J. Hanley (DEPUTY)

FILED July 27, 1981 BAKER COUNTY SURVEYOR SURVEY NO. 7-47-52