


CERTIFIED RECORD OF LAND CORNER MONUMENTATION

Index File No. Z-13

History of original corner establishment:

Corner was originally established under G. L. O. contract number 443, by William Barr on September 9, 1882. Surveyor General's notes state: "Set basalt rock 18 X 12 X 7 inches in ground for corner to Sec. 3-4-34-34 on steep hillside facing north, marked with 3 notches on the E & W edges, from which a pine 11 ins. in diam. bears N61°E, 190 lks dist. marked T7S R47E S34 BT. A pine bears 17 in. diam. bears N29°W, 181 lks dist. marked T7S R47E S33 Bt. A pine 22 ins. diam. bears S90°W, 182 lks dist. marked T8S R47E S4 BT, A pine 13 in. diam. bears S24°E, 290 lks dist. marked T8S R47E S3 BT."

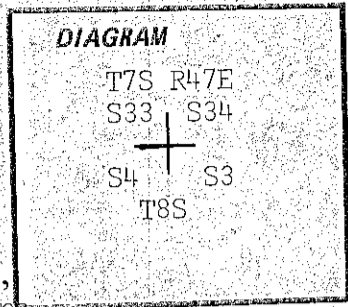

Description of corner evidence found:

Found live original BT with healed blaze (34" Ponderosa Pine Bt in SE Quad) Found cut stump with blaze and visible scribing in SW Quad. From the tree in the SW Quad which had visible scribing " 8S R47 S4 BT" we chained record bearing and distance; N9°E, 182 lks (120.1 ft.) and set a nail. We then checked the bearing from the set point to the healed tree in the SE Quad: S26°E. we then chained to the tree and found it to measure 262.4 ft. vs. record of 290 lks. closer evaluation of the tree seems to indicate that it is a healed scar rather than a blaze. We then searched for the rock and other BTs. No rock. No BTs remains SE or NW. Found a decayed stump remains N61°E, 112.4 ft. We accepted record bearing and distance from stump remains with visible scribing. We tagged this stump with 54-3 and 54-4.

Description of monument and accessories I established to perpetuate the original location of this corner:


At the center of the above point, set 2 1/2" X 30" galvanized pipe and brass cap marked: Set pipe 20" in the ground and mound of stone around to cap.

From which by magnetic declination of N20°E:

A 20" pine bears N88°E, 157.7 ft. scribed T7S R47E S34 BT.

A 11" pine bears S52°E, 46.6 ft. scribed T8S R47E S3 BT.

A 12" pine bears S25°W, 6.6 ft. T8S R47E S4 BT. A 13" pine bears N17°W, 33.1 ft. scribed T7S R47E S33 BT. Painted blazes red and 6" red band around. Placed 54-3s, 54-4s, and brass washers stamped PLS 1051 on the BTs. Placed 54-4 on a steel fence post 5' west.

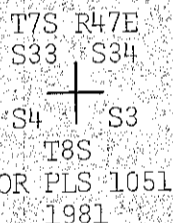

I hereby certify that the above corner monument was reestablished as herein described.

Witnesses: David Cummins
Daniel Rowland
Douglas Moser

February 5, 1981

**REGISTERED
PROFESSIONAL
LAND SURVEYOR**

Barry B. Barbour

**OREGON
OCT. 17, 1975
BARRY B. BARBOUR
1051**

Office of..... County Surveyor..... County of..... Baker.....
State of....., I hereby certify that the within instrument was filed in this office
for record on the..... day of....., 19 81
..... by *Thomas J. Stanley*
(COUNTY OFFICIAL) (DEPUTY)

FILED July 27, 1981
BAKER COUNTY SURVEYOR
SURVEY NO. 7-47-53