


SECTIONS 16 & 21

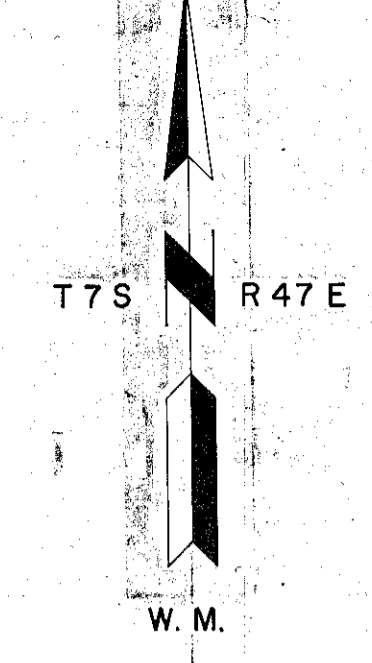

BASIS OF BEARING

SOLAR OBSERVATIONS  
2-05-81  
2-10-81

MEAN MAGNETIC DECLINATION

N 20° 00' E

**LEGEND**

- FOUND CORNER OF RECORD (BRASS CAP)
- FOUND ORIGINAL G.L.O. CORNER EVIDENCE & SET MONUMENT AS DESCRIBED.
- ⊕ SET MONUMENT FROM SURVEY AS DESCRIBED.
- POSTED FOREST SERVICE BOUNDARY.
- ( ) RECORD BEARINGS & DISTANCES
- [ ] METERS
- ⑩ SECTION NUMBER

**REFERENCE MATERIAL**

ORIGINAL G.L.O. NOTES & PLAT FIELD BOOKS 1-6.

REGISTERED PROFESSIONAL LAND SURVEYOR  
*Barry B. Barbour*  
OREGON  
OCT. 17, 1975  
BARRY B. BARBOUR  
1051

**NOTES**

FORM R6-7100-57 FILED AT BAKER COUNTY SURVEYORS FOR STANDARD INDEX FILE NUMBERS IN T7S, R47E, W.M.: J-5, J-7, J-9, J-11, J-13, L-9, L-13, N-9, N-11, N-13, O-12, O-13, P-9, P-11, P-12, P-13, R-9, R-11, R-12, & R-13.

**SURVEY HISTORY**


T7S, R47E, W.M. WAS SURVEYED BY WILLIARD B. BLAKESLEE UNDER G.L.O. CONTRACT NUMBER 707, FROM JUNE 3, 1901 TO AUGUST 5, 1901. THE WEST & SOUTH BOUNDARIES OF T7S, R47E, W.M. WERE SURVEYED BY W.B. BARR, SEPTEMBER 1882 UNDER G.L.O. CONTRACT NO. 443. THE WEST BOUNDARY OF SECTION 19, WAS SURVEYED BY HANLEY ENGINEERING IN 1979, UNDER U.S.F.S. CONTRACT.

FILED July 27, 1981  
BAKER COUNTY SURVEYOR  
SURVEY NO. 7-47-55

I, BARRY B. BARBOUR, a registered land surveyor in the State of Oregon, hereby certify that this plat and the notes hereon, or attached, are a correct representation of a survey I performed during February to June, 1981 for the U.S. Forest Service in accordance with the Statutes of the State of Oregon and with the articles of the contract.

*Barry B. Barbour*

Barry B. Barbour  
Registered Land Surveyor  
Oregon License 1051

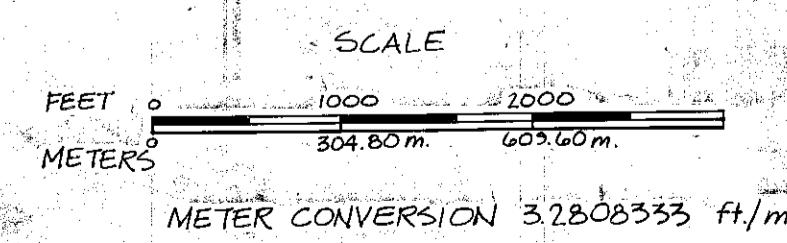

CONTRACT NO. 53-04H1-1-8289N

|                                   |  |                |
|-----------------------------------|--|----------------|
| SECTIONS 16 & 21, T7S, R47E, W.M. |  |                |
| BAKER COUNTY,                     |  | OREGON         |
| WALLOWA - WHITMAN NATIONAL FOREST |  |                |
| SCALE:<br>1" = 1000'              | BARRY B. BARBOUR<br>PROFESSIONAL LAND SURVEYOR | SHEET NO.<br>2 |
| DATE:<br>JULY, 1981               |  | 2              |