




Land Surveying & Boundary Consulting

32610 Mountain Lakes Drive
Klamath Falls, OR 97601
(541) 356-2381

CERTIFIED RECORD OF LAND CORNER MONUMENTATION

44° 56' 04.940" N
116° 55' 18.310" W
+/- 5 Meters.
NAD 83

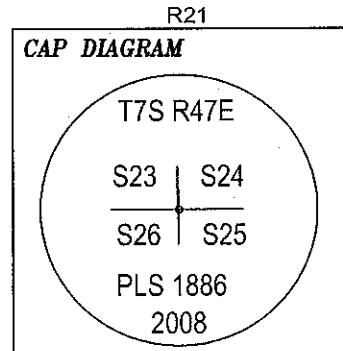

History of original corner establishment:

Williard B. Blakeslee, GLO, 1901

Monument Set:

A lava stone, 16 x 12 x 5 ins., 12 ins. in the ground, marked with 2 notches on the S and 1 on the E faces and raised a mound of stone 3 ft. base, 24 ins. high 10 lks. (6.6 ft.) W of the corner.

Barry Barbour, PLS 1051, 1981

Monument Found:

A 16 x 11 x 8 in. lava stone painted orange with 2 prominent notches on the south encircled by a mound of stone.

Monument Set:

A 2 1/2 in. galvanized iron pipe and brass cap 20 ins. in the ground with a mound of stone around to cap. Buried marked stone alongside pipe from which:

A pine, 20 ins. diam., bears S 81° W 291.5 ft. scribed T7S R47E S26 BT with a brass washer marked PLS 1051 nailed to the BT.

A steel fence post bears west 5 ft. and raised a mound of stone 3 ft. base 3 ft. high east of corner.

Description of corner evidence found:

Monument Found:

I find the 1981 Barbour monument, properly marked, out of the ground, laying against the fence post, and a lava stone 16 x 11 x 8 ins. (no marks) approximately 8 ft. west and down hill (32° slope) from the original stone mound. Barbour's fence post was firmly set in the vicinity of the rock and monument.

Accessories Found:

An embedded rock mound, approximately 3 ft. diam. and flat on the ground. I believe this is the original mound and it is in its original position. This does not look like a mound built in 1981.

A p. pine, 30 ins. diam., bears S 81° W 293.9 ft. (Record 291.5 ft.), with burned healed double blaze. The tree is alive and healthy.

Description of monument and accessories established to perpetuate corner:

Monument Set:

I measure record bearing and distance from Barbour's bearing tree and set a nail. I then measure E 6.6 ft. from the center of the embedded mound of stones. The measurement from the bearing tree is 2.4 ft. short from the measurement from the mound. I decide the measurement from the center of the mound is better.

I set a 3 1/4 in. aluminum cap on a 2 1/4 in. diam., aluminum pipe 30 ins. long (standard USDA Forest Service monument), buried 8 ins. in the ground to solid rock, with a few rocks on the downhill side.

Original stone is still approx. 8 ft. below our monument. We were not able to carry it back up the hill.

Bury Barbour's monument on the east side of the cap.

Office of.....County.....Surveyor..... County of.....Baker.....
State of.....Oregon....., I hereby certify that the within was filed
in this office for record on the..... day of....., 20.....
..... by
(COUNTY OFFICIAL) (DEPUTY)

1/9/09
REGISTERED PROFESSIONAL LAND SURVEYOR

Richard Chesebro
OREGON
JULY 18, 1880
Richard A. Chesebro
1886

Renews: 12-31-2009

FILED Jan. 14, 2009
BAKER COUNTY SURVEYOR
SURVEY NO. 7-47-61