




Land Surveying & Boundary Consulting

32610 Mountain Lakes Drive
Klamath Falls, OR 97601
(541) 356-2381

**CERTIFIED RECORD OF LAND
CORNER MONUMENTATION**

44° 56' 04.940" N
116° 55' 18.1310" W
+/- 5 Meters.
NAD 83

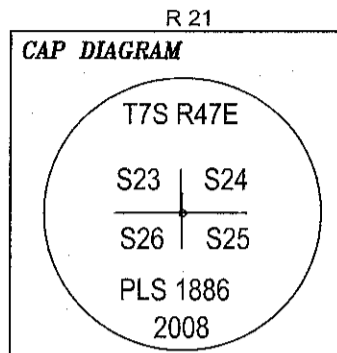


Description of monument and accessories established to perpetuate corner:

Accessories Set:

- A 5/8 x 30 in. rebar driven to solid rock with a 2 in. aluminum cap showing 5 ins. above ground bears N 32° E 5.6 ft. .
- A 5/8 x 30 in. rebar driven to solid rock with a 2 in. aluminum cap showing 6 ins. above ground bears S 42° E 4.9 ft.
- A 5/8 x 30 in. rebar driven to solid rock with a 2 in. aluminum cap showing 12 ins. above ground bears S 40° W 6.4 ft. .
- A 5/8 x 30 in. rebar driven to solid rock with a 2 in. aluminum cap showing 8 ins. above ground bears N 57° W 3.9 ft. .

Equipment: Warren Knight staff compass with tripod, Var. 15 1/2° E,
Keson tape, clinometer, loggers tape
Crew: Richard Chesebro & Ron Grace
Date: August 11, 2008

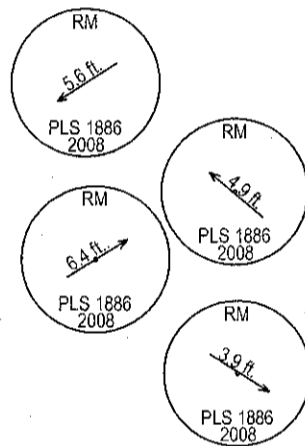

1/9/09
REGISTERED
PROFESSIONAL
LAND SURVEYOR

Richard Chesebro
OREGON
JULY 18, 1980
Richard A. Chesebro
1886
Renews: 12-31-2009

Office of.....County Surveyor..... County of.....Baker.....
State of.....Oregon....., I hereby certify that the within was filed
in this office for record on the..... day of....., 20.....
..... by
(COUNTY OFFICIAL) (DEPUTY)

FILED Jan. 14, 2009
BAKER COUNTY SURVEYOR
SURVEY NO. 7-47-61