




Land Surveying & Boundary Consulting

32610 Mountain Lakes Drive
Klamath Falls, OR 97601
(541) 356-2381

**CERTIFIED RECORD OF LAND
CORNER MONUMENTATION**

44° 56' 05.27" N
116° 54' 04.82 W
+/- 5 Meters.
NAD 83

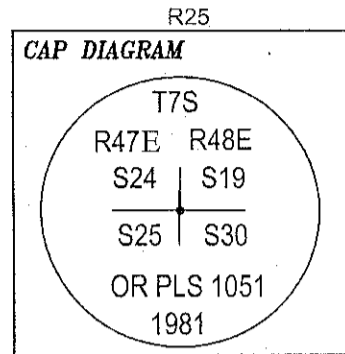

History of original corner establishment:

Williard B. Blakeslee, GLO, 1901

Monument Set:

A pauphy stone, 20 x 14 x 10 ins., 12 ins. in the ground, marked with 2 notches on the S and 4 on the north faces and raised a mound of stone 3 ft. base, 24 ins. high 10 lks. (6.6 ft.) W of the corner.

Barry Barbour, PLS 1051, 1981

Monument Found:

A 20 x 14 x 10 in. stone, 10 ins. above the ground, with 4 clear lines on the north and 2 lines on the south.

Monument Set:

A 2 1/2 in. galvanized pipe and brass cap 24 ins. in the ground with a mound of stone around the cap. Buried marked stone alongside pipe from which:

A pine, 26 ins. diam., bears S 24° W 157.2 ft. scribed T7S R47E S25 BT.

A steel fence post bears east 5 ft. and raised a mound of stone 3 ft. base 3 ft. high west of corner.

Description of corner evidence found:

Monument Found:

A 2 1/2 in. galvanized iron pipe with a 2 1/2 in. brass cap leaning 45° downhill. I set cap vertical it its same location.

I also find the original basalt stone, 17 x 12 x 8 ins. with 4 grooves on the north, 2 grooves on the south and 6 grooves on the west faces. All the grooves are clearly visible. The stone had slid approximately 2-ft. down hill.

A fence post and LSM bears east 3.5 ft. (record 5.0 ft.)

No evidence of Blakeslees mound of stone west of the corner was found.

A mound of stone, 2 ft. base, 12 ins. high was on the downhill side of the monument. The cap is located on a 34° S slope and is visible from the road.

Accessories Found:

A ponderosa pine, 30 ins. diam., bears S 19° W (record S 24°W) 157.2 ft. with a healed double blaze. The tree is alive and healthy, but has been burnt.

Description of monument and accessories established to perpetuate corner:

Monument Set:

None.


Accessories set:

A 5/8 x 30 in. rebar with 2 in. aluminum cap showing 2 ins. above ground, bears N 48° E 7.2 ft.

A 5/8 x 30 in. rebar with 2 in. aluminum cap showing 3 ins. above ground bears S 51° E 7.5 ft.

A basalt stone, 30 x 26 x 30 ins., bears S 86° W 14.1 ft. marked XBO on the SE face. The marks are 13 ins. above the ground.

A 5/8 x 30 in. rebar with 2 in. aluminum cap showing 7 ins. above the ground bears N 67° W 7.6 ft.

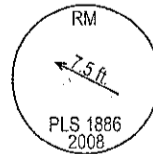

119/09
**REGISTERED
PROFESSIONAL
LAND SURVEYOR**

Richard Chesebro
OREGON
JULY 18, 1980
Richard A. Chesebro
1886

Renews: 12-31-2009

Office of.....County Surveyor..... County of.....Baker.....
State of.....Oregon....., I hereby certify that the within was filed
in this office for record on the..... day of....., 20.....
..... by
(COUNTY OFFICIAL) (DEPUTY)

FILED Jan 14 2009

BAKER COUNTY SURVEYOR
SURVEY NO. 7-47-62
7-48-15