



BAKER COUNTY
OREGON
T.7S.R.48E.W.M.ORE.

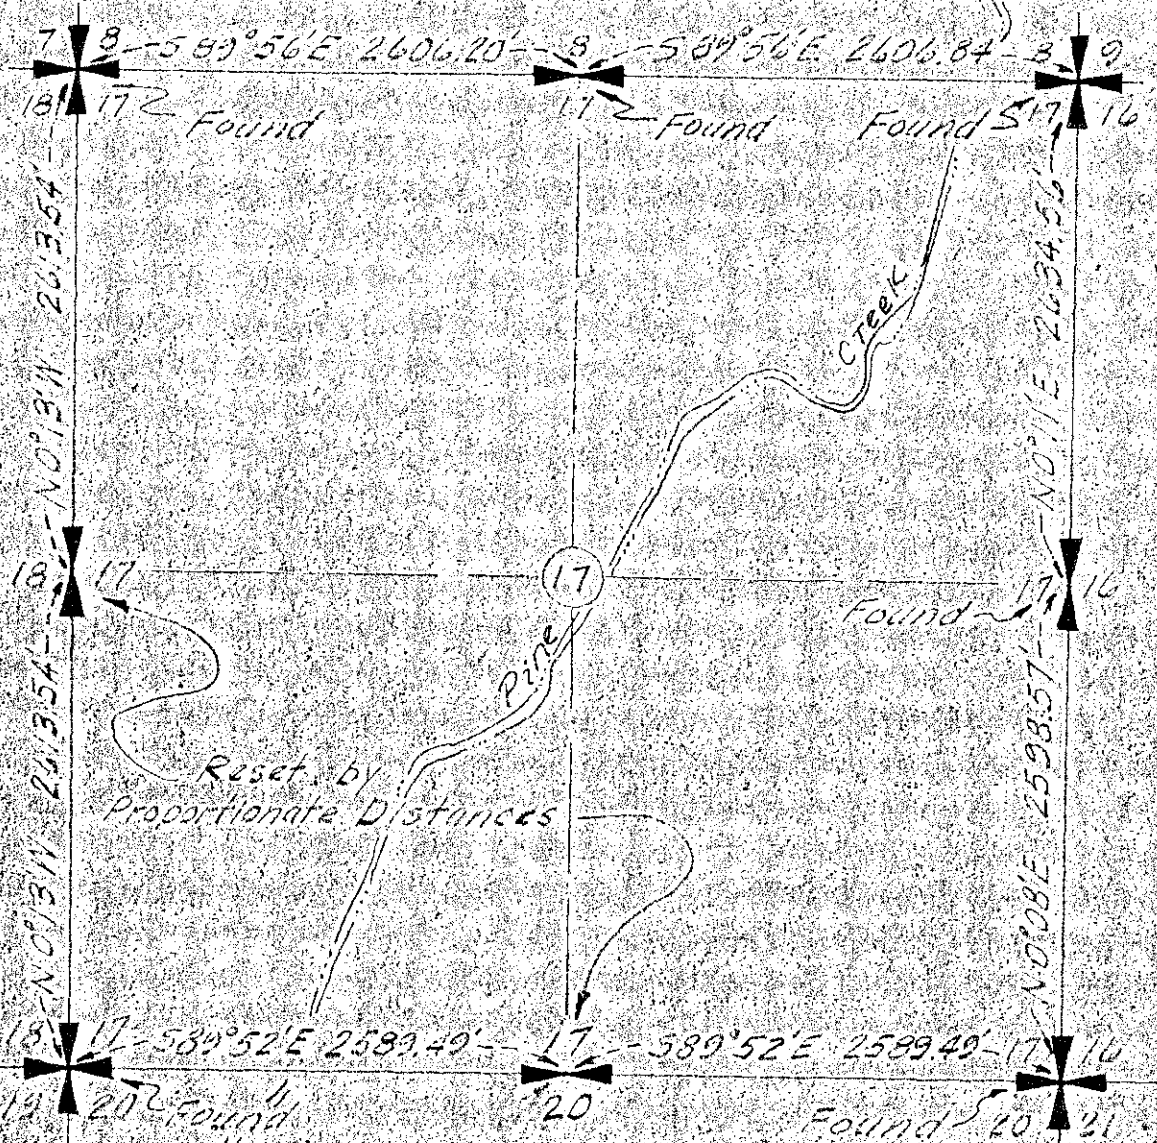

FILED Jan. 10, 1977
BAKER COUNTY SURVEYOR
SURVEY NO. 7-42-1

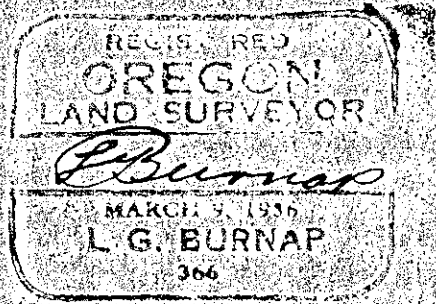

FILED 1-10-77
BAKER COUNTY SURVEYOR
SURVEY NO. 7-42-1

LEGEND:
+ FOUND OR RESET CORNERS

OXBOW H.E. DEVELOPMENT DEPENDENT RESURVEY of SEC. 17 T.7S. R.48E. W.M. ORE.	
IDAHO POWER CO. BOISE, IDAHO	
SCALE: 1" = 1000' Aug. 23, 1957	
DR. D.D.	APPROVED
T.R.	
CH	
O-5K-18 20R-26123	