


BAKER COUNTY
 OREGON
 T. 7 S. R. 48 E. W. 1/4 M. ORE.

LEGEND:
 FOUND OR RESET CORNERS

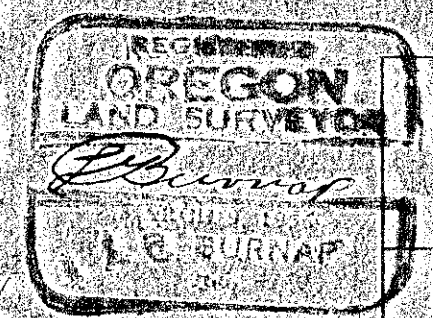

OXBOW HE DEVELOPMENT
 DEPENDENT RESURVEY of
 SEC. 20, T. 7 S. R. 48 E. W. 1/4 M. ORE.
 IDAHO POWER CO.
 BOISE, IDAHO

Jan 10, 1917
 BAKER COUNTY SURVEYOR
 SURVEY NO. 7-48-1
 SCALE: 1" = 1000'
 Aug. 24, 1957
 DR: D.D. APPROVED
 TR: [Signature]
 CH: [Signature]
 O-S-K-19
 20 R-26124
 167