

CERTIFIED RECORD OF LAND CORNER MONUMENTATION


History of original corner establishment:

Corner established by W. B. Blakeslee under GLO contract no. 707 dated April 24, 1899.

Surveyor General records state:

Set a basalt stone 20 x 12 x 8 ins, 14 ins in the ground for 1/4 sec cor, marked 1/4 S on the west face from which:

- A pine 14 ins in diam bears N 85° E, 220 lks dist marked 1/4 S 20 BT
- A pine 20 ins in diam bears S 45° W, 250 lks dist marked 1/4 S 19 BT

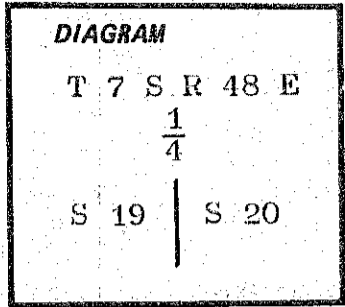

Description of corner evidence found:

Found a stone 20 x 11 x 8 ins in place and marked 1/4 on north face, from which an old mound of stones, 3 feet in diam and 1 foot high bears North, 3 feet,

Description of monument and accessories | established to perpetuate the original location of this corner:

Set a 2 1/2 inch brass cap on a 1 inch iron pipe 31 inches long and projecting 6 inches out of the ground with a surrounding rock mound. Left stone mound to north of monument in place and buried original corner stone 1 foot north of corner monument.

Brass cap marked thus: T 7 S R 48 E

1/4

S 19 | S 20


CS 1981

I hereby certify that the above described corner monument was properly established under my supervision on Feb 20, 1981, and witnessed by Brad Gordon, Tom Fisk and Jim DeMastus.

FILED April 27, 1981

BAKER COUNTY SURVEYOR

SURVEY NO. 7-48-7

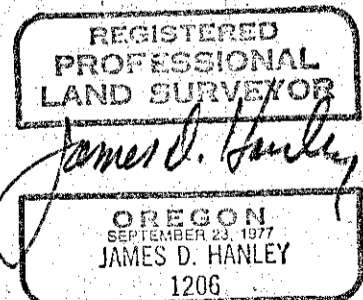

Office of..... County of.....

State of....., I hereby certify that the within instrument was filed in this office for record on the..... day of....., 19.....

..... by

(COUNTY OFFICIAL) (DEPUTY)