


CERTIFIED RECORD OF LAND CORNER MONUMENTATION

N-25

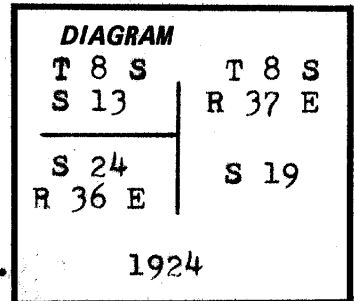

History of original corner establishment:

Corner established by Lincoln E. Wilkes under instructions dated Sept. 24, 1923, and included in Group No. 107.

Surveyor General records state:

...set an iron post, 3 ft. long, 2 ins., dia., 27 ins. in the ground, for cor. of secs. 13 and 24, only with brass cap marked as shown in diagram, from which:

A white bark pine, 18 ins. dia., bears S. 25 $\frac{1}{2}$ ^o W., 332 lks. dist., marked T 8 S R 36 E S 24 BT.

A white bark pine, 9 ins., dia., bears N. 4 $\frac{1}{2}$ ^o W., 228 lks. dist., marked T 8 S R 36 E S 13 BT.

Description of corner evidence found:

A brass cap on an iron pipe marked as shown in corner diagram.

A pine 22 inch diam bears S 25 $\frac{1}{2}$ ^o W. 332 lks. dist. with healed blaze.

No trace of original section 13 BT.

Description of monument and accessories I established to perpetuate the original location of this corner:

Improved surrounding rock mound around corner monument and set a 6 foot steel fence post alongside with a sign 54-9 attached.

New bearing tree:

A pine 12 inches diam bears N. 05^o W., 16.0 ft. dist. marked T 8 S R 36 E S 13 BT and has a brass washer marked PLS 1639 nailed flush with BT blaze.

To each bearing tree attached a sign 54-3 above BT blaze and below a 6 inch band of red paint and a sign 54-9 attached to opposite side of tree from BT blaze.

I hereby certify that the above corner monument was properly maintained to U.S.F.S. standards under my supervision on Oct. 4, 1984, and witnessed by Jim DeMastus and Daryl Schuchardt.

**REGISTERED
PROFESSIONAL
LAND SURVEYOR**

William L. Hanley

**OREGON
JULY 14, 1978
WILLIAM L. HANLEY
1639**

Office of County Surveyor County of Baker
 State of Oregon I hereby certify that the within instrument was filed in this office
 for record on the 11 day of June, 1985
 by
 (COUNTY OFFICIAL) (DEPUTY)

FILED 6-11-85
 BAKER COUNTY SURVEYOR
 SURVEY NO. 8-36-1