


CERTIFIED RECORD OF LAND CORNER MONUMENTATION

T-25 T 8 S R 36 E

History of original corner establishment:

Corner established by Lincoln E. Wilkes under instructions dated Sept. 24, 1923 and included in Group No. 107.

Surveyor General records state:

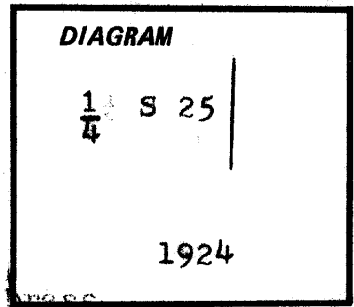

...set an iron post, 3 ft. long, 1 in. dia., 27 ins. in the ground, for 1/4 sec. cor. of sec. 25 only, with brass cap marked as shown in diagram from which:

- A black pine, 6 ins. dia., bears S. 21° W., 28 1/2 lks. dist., marked 1/4 S 25 BT.
- A black pine, 6 ins. dia., bears N. 32 1/2° W., 30 1/2 lks. dist., marked 1/4 S 25 BT.

Description of corner evidence found:

A brass cap on an iron pipe marked as shown in corner diagram.

- A 14" pine log and stump bears N 32 1/2° W, 30 1/2 lks. dist. with healed blaze.
- A 13" pine snag bears S 21° W., 28 1/2 lks dist with fragmentary scribes visible.

Description of monument and accessories established to perpetuate the original location of this corner:

Improved surrounding rock mound around corner monument and set a 6 foot steel fence post alongside with a sign 54-9 attached.

New bearing trees:

- A fir 7 inches diam bears N 63° W., 41.5 ft. dist. marked 1/4 S 25 BT.
- A fir 8 inches diam bears N 09° E., 27.9 ft. dist. marked 1/4 S 25 BT.

Each new bearing has a brass washer marked PLS 1639 nailed flush with BT blaze.

To each bearing tree attached a sign 54-3 above BT blaze and below a 6 inch band of red paint and a sign 54-9 attached to opposite side of tree from BT blaze.

I hereby certify that the above corner monument was properly maintained to U.S.F.S. standards under my supervision on Oct. 2, 1984 and witnessed by Jim DeMastus and Daryl Schuchardt.

REGISTERED PROFESSIONAL LAND SURVEYOR

William L. Hanley

OREGON JULY 14, 1978 WILLIAM L. HANLEY 1639

Office of..... County Surveyor County of..... Baker

State of..... Oregon, I hereby certify that the within instrument was filed in this office for record on the...11... day of..... June, 19...85

..... by

(COUNTY OFFICIAL) (DEPUTY)

FILED 6-11-85

BAKER COUNTY SURVEYOR

SURVEY NO. 8-36-4