


CERTIFIED RECORD OF LAND CORNER MONUMENTATION

History of original corner establishment:

The corner was originally established by Arthur Philbrick under Mineral Survey No. 477, during June and July 1902. The original notes state that at the corner a scribed black pine post 4' long by 4" sq. was set 12" in the ground and surrounded with a mound of earth from which:
 A 6" tamarack bears N31°22'E-13.03'.
 A 6" black pine bears S55°02'W-5.48'.
 Both marked B.T.K. 4-W. 1-477.

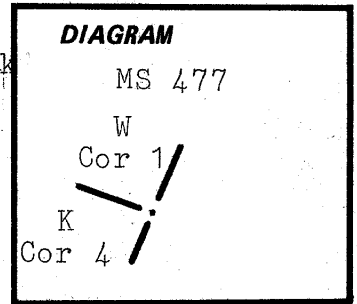

Kenton Cor 4
 Whitehall Cor 1

Description of corner evidence found:

Found scattered mound of stones from which:

An 11" western larch bears N31½°E-13.2' with healed blaze (original bearing tree). Re-established corner location by measuring record bearing and distance from face of blaze.

Description of monument and accessories I established to perpetuate the original location of this corner:

Set a 2½" by 30" aluminum pipe with a 2½" aluminum cap 20" in the ground and surrounded with a mound of earth and stone, from which:


An 8" western larch bears N68½°W-28.0' scribed 4-K-1-W-477 BT. New bearing tree has a brass washer stamped PLS 1106 nailed to the face of blaze. Attached signs 54-3 and 54-9 to each bearing tree and painted face of blaze and a 6" red band around each bearing tree. Set steel fence post on claim line near corner and attached sign 54-9.

Used steel tape and staff compass with 20°E declination, measured to the center of the bearing trees.

This corner was remonumented on July 25, 1985.

Witness: John Tuttle

Cap is marked:

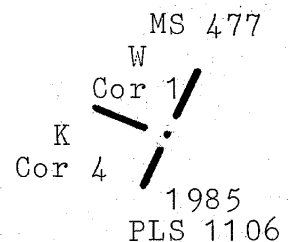

**REGISTERED
 PROFESSIONAL
 LAND SURVEYOR**

William R. Wells

**OREGON
 JULY 22, 1977
 WILLIAM R. WELLS
 1106**

Office of..... County Surveyor..... County of..... Baker.....
 State of..... Oregon....., I hereby certify that the within instrument was filed in this office
 for record on the...27... day of..... Aug....., 19...85
 by
 (COUNTY OFFICIAL) (DEPUTY)

FILED 8-27-85
 BAKER COUNTY SURVEYOR
 SURVEY NO. 8-36-58