


CERTIFIED RECORD OF LAND CORNER MONUMENTATION

History of original corner establishment:

The corner was originally established by Arthur Philbrick under Mineral Survey No. 477, during June and July 1902. The original notes state that at the corner a scribed black pine post 4' long by 4" sq. was set 12" in the ground from which:
An 8" tamarack bears S27°50'E-12.45'.
A 5" black pine bears N85°W-14.47'.
Both marked B.T.R. 5-477.

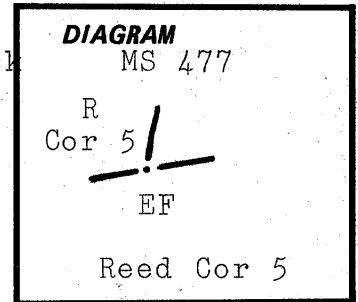

Description of corner evidence found:

Found a mound of stone and rotted remains of the post at ground level in the mound from which:

A 15" western larch stump with catface bears S28°E-12.4' (original bearing tree).

Description of monument and accessories I established to perpetuate the original location of this corner:

Set a 2 1/2" by 30" aluminum pipe with a 2 1/2" aluminum cap 24" in the ground and surrounded with a mound of stone from which:


A 7" white fir bears S26 1/2°E-25.1' scribed 5-R-477 BT.
A 10" white fir bears N70 1/2°E-17.9' scribed 5-R-477 BT.
New bearing trees have a brass washer stamped PLS 1106 nailed to the face of blaze. Attached signs 54-9 and 54-3 to each bearing tree and painted face of blaze and a 6" red band around each bearing tree. Set steel fence posts on National Forest Boundary NE of corner and attached sign 54-9 to one post and sign 54-2 to both posts.

Used steel tape and staff compass with 20°E declination, measured to the center of the bearing trees.

This corner was remonumented on July 25, 1985.

Witness: John Tuttle

Cap is marked:
MS 477

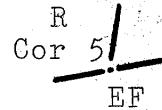

1985
PLS 1106

REGISTERED
PROFESSIONAL
LAND SURVEYOR

William R. Wells

OREGON
JULY 22, 1977
WILLIAM R. WELLS
1106

Office of..... County Surveyor..... County of..... Baker.....
State of..... Oregon....., I hereby certify that the within instrument was filed in this office
for record on the...27... day of..... Aug....., 19.85
..... by
(COUNTY OFFICIAL) (DEPUTY)

FILED 8-27-85
BAKER COUNTY SURVEYOR
SUBV. NO. 8-36-113