


CERTIFIED RECORD OF LAND CORNER MONUMENTATION

History of original corner establishment:

The corner was originally established by Arthur Philbrick under Mineral Survey No. 477, during June and July 1902. The original notes state that at the corner a scribed tamarack post 4' long by 4" sq. was set 12" in the ground and surrounded by a mound of earth from which:

- A 16" red fir bears N50°40'E-10'.
- An 8" black pine bears S30°36'W-71.86'.
- Both marked B.T.F. 1-E.F. 1-477.

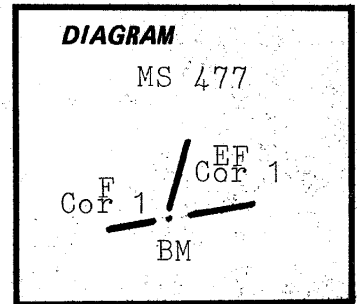

Fairview Cor 1
East Fairview Cor 1

Description of corner evidence found:

Found original post in the mound of earth at ground level from which:

- A 28" white fir stump bears N54°W-34.7' with fragmentary scribing (original bearing tree).
- A 10" dead, standing, lodgepole pine bears S31°W-72.2' with scribing visible on open blaze (original bearing tree).

Found remains of rotted post lying beside mound.

Description of monument and accessories established to perpetuate the original location of this corner:


Set a 2½" by 30" aluminum pipe with a 2½" aluminum cap 24" in the ground and surrounded with a mound of earth and a few stones. Placed remains of original post on the mound. From the monument:

- An 11" alpine fir bears S59½°E-25.2' scribed 1-F-1-EF-477 BT.
- An 8" white fir bears N39¼°W-17.9' scribed 1-F-1-EF-477 BT.
- New bearing trees have a brass washer stamped PLS 1106 nailed to the face of blaze. Attached signs 54-9 and 54-3 to each bearing tree and painted face of blaze and a 6" red band around each bearing tree. Set steel fence post on claim line near corner and attached sign 54-9.

Used steel tape and staff compass with 20°E declination, measured to the center of the bearing trees.

This corner was remonumented on July 26, 1985.

Witness: John Tuttle

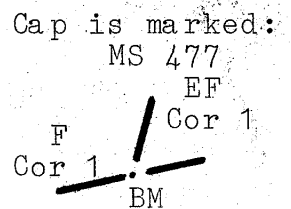

1985
PLS 1106

**REGISTERED
PROFESSIONAL
LAND SURVEYOR**

William R. Wells

**OREGON
JULY 22, 1977
WILLIAM R. WELLS
1106**

Office of.....County...Surveyor..... County of.....Baker.....
State of.....Oregon....., I hereby certify that the within instrument was filed in this office
for record on the...27... day of.....Aug....., 1985

..... by
(COUNTY OFFICIAL) (DEPUTY)

FILED 8-27-85
BAKER COUNTY SURVEYOR
SURVEY NO. 8-36-1514
9-36-