


CERTIFIED RECORD OF LAND CORNER MONUMENTATION

History of original corner establishment:

The corner was originally established by Arthur Philbrick under Mineral Survey No. 477, during the survey of June and July 1902. The original notes state that at the corner a scribed black pine post 4' long by 4" sq. was set 12" in the ground and surrounded with a mound of earth from which:

A 10" black pine bears S26°25'W-14.38'.
An 8" black pine bears N3°25'W-9.95'.
Both marked B.T.K.3-W.2-477.

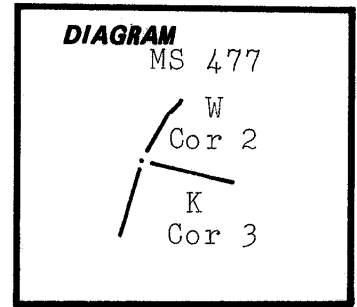

Kenton Cor. 3
Whitehall Cor. 2

Description of corner evidence found:

Found the mound of earth and the rotted remains of the post at ground level from which:

A 10" dead standing lodgepole pine bears N3°W-10.1' with scribing visible on open blaze (original bearing tree).
A 10" down lodgepole pine bears S26½°W-14.7' with scribing visible on open blaze (original bearing tree).

Description of monument and accessories I established to perpetuate the original location of this corner:

Set a 2½" by 30" aluminum pipe with a 2½" aluminum cap 24" in the ground and surrounded with a mound of earth from which:


A 9" alpine fir bears S83½°W-31.0' scribed 3-K-2-W-477 BT.
An 8" alpine fir bears S34½°W-18.0' scribed 3-K-2-W-477 BT.
New bearing trees have a brass washer stamped PLS 1106 nailed to face of blaze. Attached signs 54-3 and 54-9 to each bearing tree and painted face of blaze and a 6" red band around each bearing tree. Set steel fence posts on National Forest Boundary SW and NE of corner and attached sign 54-9 to one post and sign 54-2 to both posts.

Used steel tape and staff compass with 20°E declination, measured to the center of the bearing trees.

This corner was remonumented on August 9, 1985.

Witness: John Tuttle

Cap is marked:

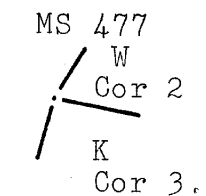

1985
PLS 1106

REGISTERED
PROFESSIONAL
LAND SURVEYOR

William R. Wells

OREGON
JULY 22, 1977
WILLIAM R. WELLS
1106

Office of...County...Surveyor..... County of...Baker.....

State of...Oregon..... I hereby certify that the within instrument was filed in this office for record on the...8... day of...Oct....., 1985

..... by
(COUNTY OFFICIAL) (DEPUTY)