


CERTIFIED RECORD OF LAND CORNER MONUMENTATION

History of original corner establishment:

This corner was originally established by Arthur Philbrick under Mineral Survey No. 477, during June and July 1902. The original notes state that at the corner a chiseled granite rock, 48" by 36" by 24", was above the natural surface with a mound of rocks from which:

- A 12" tamarack bears N57°W-3.54'.
 - A 6" red fir bears S30°E-1.55'.
 - A 12" black pine bears N59°45'W-8.06'.
- All scribed B.T.K.1-477.

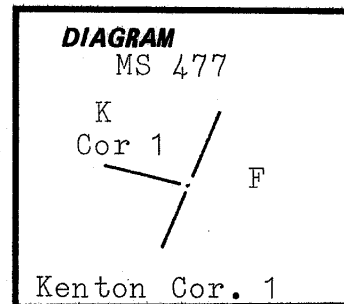

Description of corner evidence found:

A 4' by 2½' by 2½' granite rock in place with a very faint and weathered "X" and evidence of marks K.1-477 on the rock below the "X" from which:

- A 17" western larch bears N57°W-3.5' with healed blaze (original bearing tree).
- An 11" douglas fir bears S10°E-1.8' with healed blaze (original bearing tree).
- A 10" down, rotten lodgepole pine bears N59 3/4°E-8'± with scribing visible on partly healed blaze (original bearing tree).

Description of monument and accessories established to perpetuate the original location of this corner:

A 3" brass disk in mortar at the corner point.


Attached signs 54-3 and 54-9 to each bearing tree and painted face of blaze and a 6" red band around each bearing tree. Set steel fence posts on National Forest Boundary SW and NW of corner and attached sign 54-9 to one post and sign 54-2 to both posts.

Used steel tape and staff compass with 20°E declination, measured to the center of the bearing tree.

This corner was remonumented on September 10, 1985.

Cap is marked:

MS 477

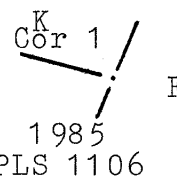

REGISTERED
PROFESSIONAL
LAND SURVEYOR

William R. Wells

OREGON
JULY 22, 1977
WILLIAM R. WELLS
1106

Office of.....County Surveyor..... County of.....Baker.....
State of.....Oregon....., I hereby certify that the within instrument was filed in this office
for record on the...8... day of.....Oct....., 19.85

..... by
(COUNTY OFFICIAL) (DEPUTY)

FILED
BAKER COUNTY SURVEYOR
SURVEY NO. 8-36-27