


CERTIFIED RECORD OF LAND CORNER MONUMENTATION

History of original corner establishment:

This corner was originally established by Arthur Philbrick under Mineral Survey No. 477, during June and July 1902. The original notes state that at the corner a scribed tamarack post 4' long by 4" sq. was set 12" in the ground and surrounded with a mound of earth from which:
A 4" red fir bears N42°45'W-19.68'.
A 24" tamarack bears S76°14'W-23.58'.
Both marked B.T.M.2-477.

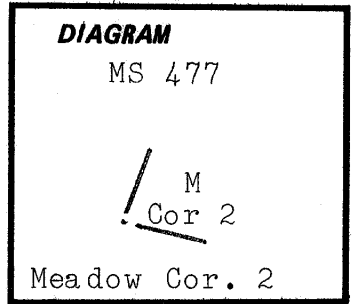

Description of corner evidence found:

~~Found the rotted remains of the post at ground level in a mound of earth from which:~~

A 22" western larch bears S76¼°W-24.4' with visible scribing on partly healed blaze (original bearing tree).
An 11" alpine fir bears N42°W-19.6' with visible scribing on partly healed blaze (original bearing tree).

Also, found the remains of the original post lying beside the mound.

Description of monument and accessories | established to perpetuate the original location of this corner:

Set a 2½" by 30" aluminum pipe with a 2½" aluminum cap 22" in the ground and surrounded with a mound of earth and stone. Placed the original post on the mound.

Attached sign 54-3 and 54-9 to each bearing tree and painted face of blaze and a 6" red band around each bearing tree. Set steel fence posts on National Forest Boundary NE and SE of corner and attached sign 54-9 to one post and sign 54-2 to both posts.


Used steel tape and staff compass with 20°E declination, measured to the center of the bearing trees.

This corner was remonumented on August 29, 1985.

Witness: John Tuttle

Cap is marked:

MS 477

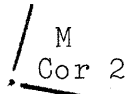

1985
PLS 1106

REGISTERED
PROFESSIONAL
LAND SURVEYOR

William R. Wells

OREGON
JULY 22, 1977
WILLIAM R. WELLS
1106

Office of.....County...Surveyor..... County of...Baker.....

State of.....Oregon....., I hereby certify that the within instrument was filed in this office for record on the...8... day of.....Oct....., 19.85

..... by
(COUNTY OFFICIAL) (DEPUTY)