


**CERTIFIED RECORD OF LAND CORNER MONUMENTATION**

**History of original corner establishment:**

This corner was originally established by Arthur Philbrick under Mineral Survey No. 477, during June and July 1902. The original notes state that at the corner a scribed tamarack post 4' long by 4" sq. was set 12" in the ground and surrounded with a mound of earth and stone from which: A 48" tamarack bears S60°15'E-20.15'. A 20" black pine bears N25°45'E-17.33'. Both marked B.T.M.3-477.

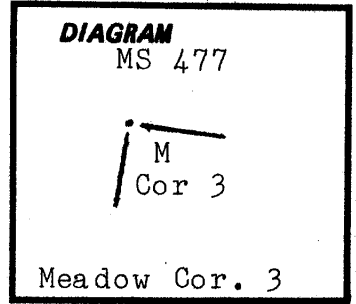

**Description of corner evidence found:**

A mound of earth and stone with rotted remains of the post at ground level from which:

A 45" western larch bears S61°E-21.5' with scribing visible on partly healed blaze (original bearing tree).  
An 18" dead lodgepole pine bears N27½°E-18.2' with scribing visible on partly healed blaze (original bearing tree).

**Description of monument and accessories I established to perpetuate the original location of this corner:**

Set a 2½" by 30" aluminum pipe with a 2½" aluminum cap 15" in the ground and surrounded with a mound of earth and stones from which:

A 6" alpine fir bears S55½°W-14.3' scribed 3-M-477 BT. New bearing tree has a brass washer stamped PLS 1106 nailed to face of blaze. Attached signs 54-3 and 54-9 to each bearing tree and painted face of blaze and a 6" red band around each bearing tree. Set steel fence posts on National Forest Boundary SE and SW of corner and attached sign 54-9 to one post and sign 54-2 to both posts.

Cap is marked:  
MS 477

Used steel tape and staff compass with 20°E declination, measured to the center of the bearing trees.

This corner was remonumented on August 29, 1985.

M  
Cor 3  
1985  
PLS 1106

Witness: John Tuttle

REGISTERED  
PROFESSIONAL  
LAND SURVEYOR

*William R. Wells*

OREGON  
JULY 22, 1977  
WILLIAM R. WELLS  
1106

Office of.....County.....Surveyor..... County of.....Baker.....  
State of.....Oregon....., I hereby certify that the within instrument was filed in this office  
for record on the...2... day of.....Oct....., 1985  
..... by .....

(COUNTY OFFICIAL)

(DEPUTY)