


CERTIFIED RECORD OF LAND CORNER MONUMENTATION

History of original corner establishment:

This corner was originally established by Arthur Philbrick under Mineral Survey No. 477, during June and July 1902. The original notes state that at the corner a scribed tamarack post 4' long by 4" sq. was set 12" in the ground and surrounded with a mound of earth and stone from which:
A 14" red fir bears S59°20'W-39.51'.
A 10" black pine bears N54°12'E-9.78'.
Both marked B.T.M.W.C.-477.

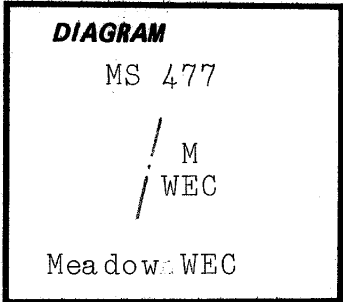

Description of corner evidence found:

A 12" dead, lodgepole pine bears N54½°E-9.8' to face of blaze and 10.2' to center line with visible scribing on partly healed blaze (original bearing tree).
A 22" down white fir bears S60°W-40'± with scribing visible on partly healed blaze (original bearing tree).

Corner position was re-established by record bearing and distance from lodgepole pine bearing tree measuring to face of blaze.

Description of monument and accessories established to perpetuate the original location of this corner:

Set a 2½" by 30" aluminum pipe with a 2½" aluminum cap 24" in the ground and surrounded with a mound of earth and stone from which:

A 7" lodgepole pine bears N46¼°W-25.3' scribed WEC-M-477 BT.
A 9" alpine fir bears N78½°W-35.6' scribed WEC-M-477 BT.
New bearing trees have a brass washer stamped PLS 1106 nailed to face of blaze. Attached sign 54-9 and 54-3 to each bearing tree and painted face of blaze and a 6" red band around each bearing tree. Set steel fence posts on National Forest Boundary NE and SW of corner and attached sign 54-9 to one post and sign 54-2 to both posts.

Used steel tape and staff compass with 20°E declination, measured to the center of the bearing trees.

Cap is marked:
MS 477
/ M
/ WEC
1985
PLS 1106

This corner was remonumented on August 29, 1985.

Witness: John Tuttle

REGISTERED
PROFESSIONAL
LAND SURVEYOR

William R. Wells

OREGON
JULY 22, 1977
WILLIAM R. WELLS
1106

Office of.....County Surveyor.....County of.....Baker.....
State of.....Oregon....., I hereby certify that the within instrument was filed in this office
for record on the...8... day of.....Oct....., 1985
..... by
(COUNTY OFFICIAL) (DEPUTY)