


CERTIFIED RECORD OF LAND CORNER MONUMENTATION

History of original corner establishment:

This corner was originally established by Arthur Philbrick under Mineral Survey No. 477, during June and July 1902. The original notes state that at the corner a scribed tamarack post 4' long by 4" sq. was set 12" in the ground and surrounded with a mound of stone from which:

- A 10" black pine bears N60°15'W-11.02'.
- A 6" black pine bears N29°55'E-14.66'.
- Both marked B.T.R.4-477.

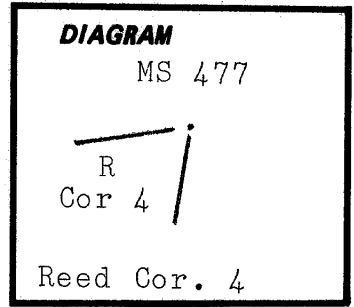

Description of corner evidence found:

Found a mound of stone with the rotted remains of the post in a hole in the mound from which:

An 8" up-rooted lodgepole pine bears N30°E-15'± with visible scribing (original bearing tree).

Description of monument and accessories I established to perpetuate the original location of this corner:

Set a 2½" by 30" aluminum pipe with a 2½" aluminum cap 24" in the ground and surrounded with a mound of earth and stone from which:


- A 13" white fir bears N20°E-9.1' scribed 4-R-477 BT.
- A 6" red fir bears N19½°W-25.3' scribed 4-R-477 BT.
- New bearing trees have a brass washer stamped PLS 1106 nailed to the face of blaze.
- Attached sign 54-3 and 54-9 to each bearing tree and painted face of blaze and a 6" red band around each bearing tree.
- Set steel fence posts on National Forest Boundary SW of corner and attached sign 54-9 to one post and sign 54-2 to both posts.

Used steel tape and staff compass with 20°E declination, measured to the center of the bearing trees.

This corner was remonumented on August 28, 1985.

Witness: John Tuttle

Cap is marked:
MS 477

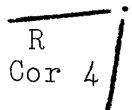

1985
PLS 1106

REGISTERED
PROFESSIONAL
LAND SURVEYOR

William R. Wells

OREGON
JULY 22, 1977
WILLIAM R. WELLS
1106

Office of..... County Surveyor..... County of..... Baker.....
 State of..... Oregon....., I hereby certify that the within instrument was filed in this office
 for record on the... 8... day of..... Oct....., 19 85
 by
 (COUNTY OFFICIAL) (DEPUTY)