


CERTIFIED RECORD OF LAND CORNER MONUMENTATION

History of original corner establishment:

The corner was originally established by Arthur Philbrick under Mineral Survey No. 477, during the survey of June and July 1902. The original notes state that at the corner a scribed tamarack post 4' long by 4" sq. was set 12" in the ground and surrounded with a mound of earth and stone from which:

- A 12" red fir bears S9°14'W-14.56'.
- A 24" red fir bears N36°47'E-6.97'.
- Both marked B.T.R.2-M.4-477.

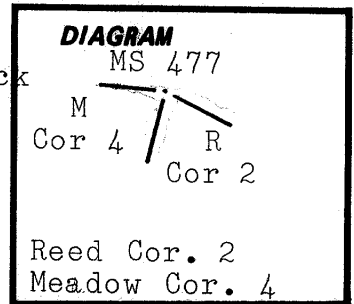

Description of corner evidence found:

Found the rotted remains of the post at ground level from which:

- A 24" white fir bears S9¼°W-15.1' with healed blaze (original bearing tree).
- A 24" down rotten white fir bears N37°E-7'±, with no scribing visible (original bearing tree).

Description of monument and accessories I established to perpetuate the original location of this corner:


Set a 2½" by 30" aluminum pipe with a 2½" aluminum cap 24" in the ground and surrounded with a mound of earth and stone from which:

- A 12" white fir bears N82½°E-18.1' scribed 2-R-4-M-477 BT.
- New bearing tree has a brass washer stamped PLS 1106 nailed to face of blaze.
- Attached sign 54-3 and 54-9 to each bearing tree and painted face of blaze and a 6" red band around each bearing tree.
- Set steel fence post on National Forest Boundary NW and SE of corner and attached sign 54-9 to one post and sign 54-2 to both posts.

Used steel tape and staff compass with 20°E declination, measured to the center of the bearing trees.

This corner was remonumented on August 9, 1985.

Witness: John Tuttle

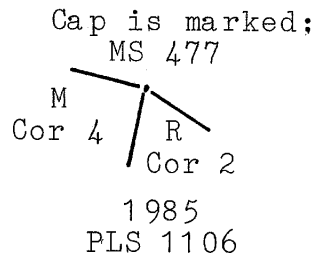

REGISTERED
PROFESSIONAL
LAND SURVEYOR

William R. Wells

OREGON
JULY 22, 1977
WILLIAM R. WELLS
1106

Office of.....County...Surveyor..... County of.....Baker.....
State of.....Oregon....., I hereby certify that the within instrument was filed in this office
for record on the...8... day of.....Oct....., 19.85

..... by
(COUNTY OFFICIAL) (DEPUTY)