


CERTIFIED RECORD OF LAND CORNER MONUMENTATION

History of original corner establishment:

The corner was originally established by Arthur Philbrick under Mineral Survey No. 477, during his survey in June and July 1902. The original notes state that at the corner a scribed tamarack post 4' long by 4" sq. was set 12" in the ground and surrounded with a mound of earth from which:

- A 6" red fir bears S71°40'W-14.9'.
- A 12" tamarack bears N13°25'W-25.35'.
- Both marked B.T.R.W.C.-M.E.C.-477.

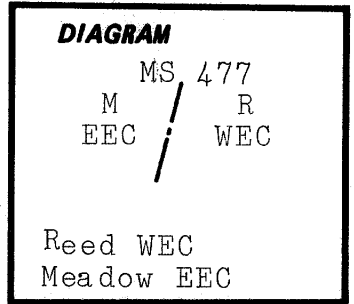

Description of corner evidence found:

Found a mound of earth with the rotted remains of the post at ground level from which:

- A 22" western larch bears N14½°E-25.6' with healed blaze (original bearing tree).
- A 14" down white fir bears S71°W-15'± with scribing under the tree (original bearing tree).

Description of monument and accessories I established to perpetuate the original location of this corner:

Set a 2½" by 30" aluminum pipe with a 2½" aluminum cap 22" in the ground and surrounded with a mound of earth and stone from which:

An 11" white fir bears N53½°W-8.9' scribed WEC-R-EEC-M-477 BT. New bearing tree has a brass washer stamped PLS 1106 nailed to face of blaze. Attached sign 54-3 and 54-9 to each bearing tree and painted face of blaze and a 6" red band around each bearing tree. Set steel fence post on claim line near corner and attached sign 54-9.

Used steel tape and staff compass with 20°E declination, measured to the center of the bearing trees.

Cap is marked:

This corner was remonumented on August 9, 1985.

Witness: John Tuttle

REGISTERED
PROFESSIONAL
LAND SURVEYOR

William R. Wells

OREGON
JULY 22, 1977
WILLIAM R. WELLS
1106

Office of.....County Surveyor..... County of.....Baker.....
 State of.....Oregon....., I hereby certify that the within instrument was filed in this office
 for record on the...8... day of.....Oct....., 1985
 by
 (COUNTY OFFICIAL) (DEPUTY)