


**CERTIFIED RECORD OF LAND CORNER MONUMENTATION**

**History of original corner establishment:**

This corner was not "originally established".

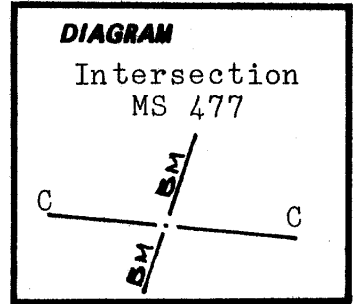

Bald Mountain-Cheboygan

**Description of corner evidence found:**

This corner was not "originally established".

**Description of monument and accessories I established to perpetuate the original location of this corner:**

Set a 2½" by 30" aluminum pipe with a 2½" aluminum cap 22" in the ground and surrounded with a mound of earth and stone from which:

A 12" engleman spruce bears S89°E-41.2' scribed Intex-BM-C-477 BT.  
A 13" engleman spruce bears S40½°E-35.9' scribed Intex-BM-C-477 BT.  
New bearing trees have a brass washer stamped PLS 1106 nailed to face of blaze. Attached sign 54-3 and 54-9 to each bearing tree and painted face of blaze and a 6" red band around each bearing tree. Set steel fence posts on National Forest Boundary SE of corner and attached sign 54-9 to one post and sign 54-2 to both posts.

Used steel tape and staff compass with 20°E declination, measured to the center of the bearing trees.

This corner was remonumented on August 30, 1985.


Witness: John Tuttle

REGISTERED  
PROFESSIONAL  
LAND SURVEYOR

*William R. Wells*

OREGON  
JULY 22, 1977  
WILLIAM R. WELLS  
1106

Cap is marked:

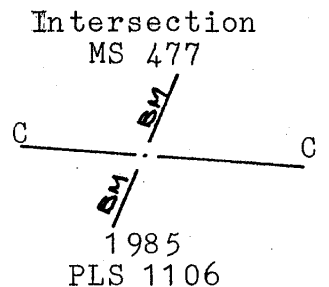

Office of.....County...Surveyor..... County of...Baker.....  
State of.....Oregon....., I hereby certify that the within instrument was filed in this office  
for record on the...8... day of.....Oct......, 1985  
..... by .....  
(COUNTY OFFICIAL) (DEPUTY)

Form R6-7100-57 (9/71)

★U.S. GOVERNMENT PRINTING OFFICE-1983-793-276

FILED \_\_\_\_\_  
BAKER COUNTY SURVEYOR  
SURVEY NO. 8-36-38  
9-36-