


**CERTIFIED RECORD OF LAND CORNER MONUMENTATION**

**History of original corner establishment:**

This corner was originally established by Arthur Philbrick under Mineral Survey No. 477, during June and July 1902. The original notes state that at the corner a scribed tamarack post 4' long by 4" sq. was set 12" in the ground and surrounded with amount of earth and stone from which: An 8" black pine bears S17°21'W-8.05'. A 12" black pine bears N85°W-1.05'. Both marked B.T.C.W.C.-477.

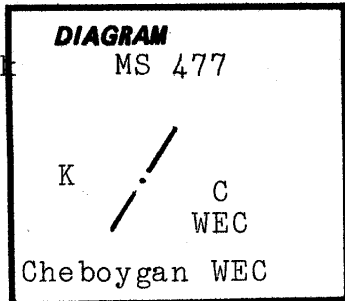

**Description of corner evidence found:**

Found the rotted remains of the original post at ground level from which:  
A rotten lodgepole pine stump bears N85°W-1.5' with scribing visible on a piece of wood beside stump (original bearing tree).  
Rotten remains of a lodgepole pine with axe marks bear S17½°W-8'±. Too rotten to attach signs. (original bearing tree).

**Description of monument and accessories | established to perpetuate the original location of this corner:**

Set a 2½" by 30" aluminum pipe with a 2½" aluminum cap 24" in the ground and surrounded with a mound of earth and stone from which:


A 10" alpine fir bears S57½°E-10.1' scribed WEC-C-477 BT.  
An 11" white fir bears S15½°W-13.6' scribed WEC-C-477 BT.  
New bearing trees have a brass washer stamped PLS 1106 nailed to face of blaze. Attached signs 54-3 and 54-9 to each bearing tree and painted face of blaze and a 6" red band around each bearing tree. Set steel fence posts on claim line near corner and attached sign 54-9.

Used steel tape and staff compass with 20°E declination, measured to the center of the bearing trees.

This corner was remonumented on August 28, 1985.

Witness: John Tuttle

Cap is marked:

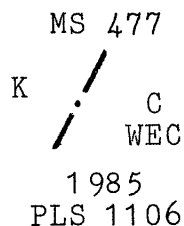

REGISTERED  
PROFESSIONAL  
LAND SURVEYOR

*William R. Wells*

OREGON  
JULY 22, 1977  
WILLIAM R. WELLS  
1106

Office of County Surveyor ..... County of Baker .....  
State of Oregon ..... I hereby certify that the within instrument was filed in this office  
for record on the 8 day of Oct ..... 1985.  
..... by .....  
(COUNTY OFFICIAL) (DEPUTY)

FILED \_\_\_\_\_  
BAKER COUNTY SURVEYOR  
SURVEY NO. 8-36-43  
9-36-