


CERTIFIED RECORD OF LAND CORNER MONUMENTATION

History of original corner establishment:

This corner was originally established by Arthur Philbrick under Mineral Survey No. 477, during June and July 1902. The original notes state that at the corner a scribed black pine post 4' long by 4" sq. was set 12" in the ground and surrounded with a mound of earth.

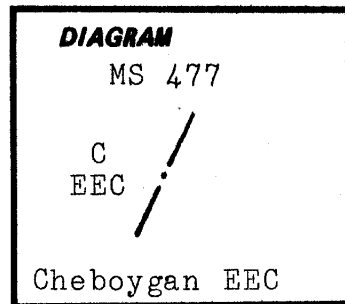

Description of corner evidence found:

Found the rotted remains of the original post lying beside an earth mound. Also, found the remains of the original post below ground.

Description of monument and accessories established to perpetuate the original location of this corner:

Set a 2 1/2" by 30" aluminum pipe with a 2 1/2" aluminum cap 26" in the ground and surrounded with a mound of earth and stone from which:

A 10" white fir bears N83 1/2° E-42.3' scribed EEC-C-477 BT.
A 6" white fir bears S14 1/2° W-11.0' scribed EEC-C-477 BT.
New bearing trees have a brass washer stamped PLS 1106 nailed to face of blaze. Attached signs 54-3 and 54-9 to each bearing tree and painted face of blaze and a 6" red band around each bearing tree. Set steel fence posts on National Forest Boundary NE and SW of corner and attached sign 54-9 to one post and sign 54-2 to both posts.

Used steel tape and staff compass with 20° E declination, measured to the center of the bearing trees.

This corner was remonumented on August 28, 1985.

Witness: John Tuttle

Placed remains of the original wood post on the new mound.

Cap is marked:

MS 477
C
EEC
1985
PLS 1106

REGISTERED
PROFESSIONAL
LAND SURVEYOR

William R. Wells

OREGON
JULY 22, 1977
WILLIAM R. WELLS
1106

Office of... County Surveyor... County of... Baker
State of... Oregon... I hereby certify that the within instrument was filed in this office
for record on the... 8... day of... Oct... 1985
..... by

(COUNTY OFFICIAL)

(DEPUTY)

FILED
BAKER COUNTY SURVEYOR
SURVEY NO. 8-36-44
9-36-