


CERTIFIED RECORD OF LAND CORNER MONUMENTATION

History of original corner establishment:

This corner was originally established by Otis Gould, U.S. Cadastral Surveyor, under special instructions dated Nov. 27, 1935, during his surveys in July through October, 1937. The original notes state that at the corner a marked brass cap on a 2" by 3' long iron post was set 20" in the ground to bedrock and surrounded with a mound of stone to the top from which:

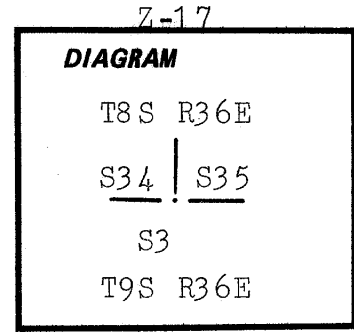

- A 10" fir bears N40°E-102 lks, marked T8S R36E S35 BT.
- A 24" tamarack bears N25°W-126 lks, marked T8S R36E S34 BT.

Description of corner evidence found:

A 2 1/2" brass cap on a 2" iron pipe protruding 9" from an earth mound from which:

- A 25" western larch bears N27°W-83.0' with healed blaze.
- A 14" white fir bears N51°E 66.0' with healed blaze.

Description of monument and accessories | established to perpetuate the original location of this corner:


Built a mound of stone to the cap on the monument. Attached sign 54-3 and 54-9 and painted face of blaze and a 6" red band around each bearing tree. Set steel fence post East of corner and attached sign 54-9.

Used steel tape and staff compass with 20°E declination, measured to the center of the bearing trees.

The cap is a standard GLO brass cap marked:

This corner was maintained on September 24, 1985.

Witness: Bob English.

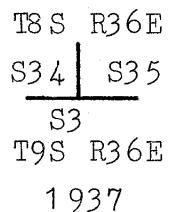

**REGISTERED
PROFESSIONAL
LAND SURVEYOR**

William R. Wells

**OREGON
JULY 22, 1977
WILLIAM R. WELLS
.1106**

Office of County Surveyor County of Baker

State of Oregon, I hereby certify that the within instrument was filed in this office
for record on the..... day of....., 19.....

..... by

(COUNTY OFFICIAL) (DEPUTY)

FILED 2-12-1986

BAKER COUNTY SURVEYOR

SURVEY NO. 8-36-51