


CERTIFIED RECORD OF LAND CORNER MONUMENTATION

INDEX MS 800

History of original corner establishment:

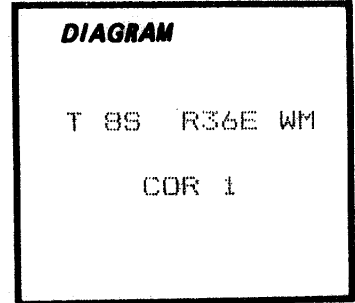

A. Ira L. Hoffman, U.S. Deputy Mineral Surveyor, under Mineral Survey No. 800 surveyed the Richard Woods claim known as Morning Star Lode from October 11, 1917 to September 19, 1918 and approved by the U.S. Surveyor General's Office 19 November, 1918. Otis O. Gould, U.S. Deputy Surveyor did a dependent resurvey under special instructions dated 27 Nov. 1935, and approved 17 August, 1939.

SURVEYOR GENERAL'S RECORD STATES: (Otis O. Gould)

Set an iron post, 3 ft. long, 1 in. diam., 8 in. in the ground to bedrock with brass cap marked:  
No bearing trees available

Description of corner evidence found:

1
MS
800
1937

B. MONUMENT FOUND:

I found a 2.5" dia. brass cap on a 1.0" dia. iron pipe 15" exposed in stone mound remnant. The pipe was bent to the south but vertical in the ground. The cap was marked:

U S GENERAL LAND OFFICE SURVEY  
PENALTY \$250 FOR REMOVAL

ACCESSORIES FOUND:

1
MS 800
1937

NONE

Description of monument and accessories I established to perpetuate the original location of this corner:

CORNER WORK DONE ON 6/12/90

C. I carefully straightened the pipe to vertical and piled stones to top.

NEW ACCESSORIES ESTABLISHED

A Grand Fir, 17" dia. bears S85W, 22.9 ft.; scribed COR 1 MS 800 BT  
A Grand Fir, 14" dia. bears N33W, 52.6 ft., scribed COR 1 MS 800 BT

Painted the blaze red on each BT  
Painted a 6" wide red band around each BT  
Placed brass washer marked "PLS 2060" at base of each BT blaze  
Placed metal sign with bearing and distance information on each BT (54-3)  
Placed metal ATTENTION sign on each BT (54-4)  
Placed 6 ft. steel fence post at corner with metal PROPERTY BOUNDARY sign and metal ATTENTION sign (54-2 and 54-4) attached

I measured to the centerline of each bearing tree using tape and hand compass with declination set at 20 degrees east.

REGISTERED PROFESSIONAL LAND SURVEYOR
---

*Edwin A. Stryker*

OREGON JULY 15, 1983 EDWIN A. STRYKER 2060
---

Office of..... County of.....  
State of....., I hereby certify that the within instrument was filed in this office  
for record on the..... day of....., 19.....  
..... by .....

(COUNTY OFFICIAL)

(DEPUTY)

FILED 11-16-1990  
BAKER COUNTY SURVEYOR  
SURVEY NO. 8-36-54