


CERTIFIED RECORD OF LAND CORNER MONUMENTATION

INDEX MS 485

History of original corner establishment:

A. Arthur Philbrick, U.S. Deputy Mineral Surveyor, under Mineral Survey No. 485 surveyed the Peter D. Estes and Joseph D. Young claim known as the Gold Hill Lode Mining Claim 27 July, to 28 July, 1902 and approved by the U.S. Surveyor General's Office.

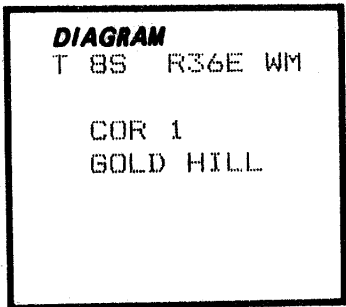

SURVEYOR GENERAL'S RECORD STATES:

Identical with Cor. No. 1, Red Fox Lode, MS 481.
A red fir post, 4 ft. long, 4 ins. square, set 12 ins. in the ground, with mound of earth, scribed RF 1 481 GH 1 485, whence the 1/4 Sec. Cor. on North boundary of Sec. 2, T9S, R36E, WM, bears S54-12E, 307.5 ft.
A red fir, 8 ins. diam., bears N83-31E, 6.44 ft., and a tamarack, 30 ins. diam., bears S43-10W, 24.44 ft., each blazed and scribed
BT RF 1 481 GH 1 485

Description of corner evidence found:

B. MONUMENT FOUND:

I found a 4"x3"x4" rotted powdery remains of wood post 14" in the ground on large stone.


ACCESSORIES FOUND:

21" dia. Grand Fir bears N87E, 7.0 ft. with healed blaze. (did not open)
Western Larch sawn stump bears S47W, 25.4 ft. with no visible marks.

Description of monument and accessories I established to perpetuate the original location of this corner:

CORNER WORK DONE ON 6/19/90

C. At the position of the pointed post remnant, set a 2.5" dia. by 30" long aluminum pipe with a 2.5" dia. aluminum cap. The pipe is set 18" in the ground with a mound of stone to 3" of the top. The cap is marked:

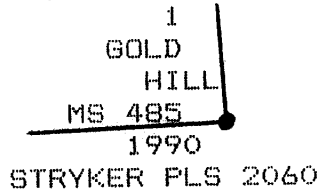

NEW ACCESSORIES ESTABLISHED

23" dia. Grand Fir bears N9W, 20.7 ft.; scribed 1 MS 485 GH BT

Painted the blaze red on each BT
Painted a 6" wide red band around each BT
Placed brass washer marked "PLS 2060" at base of each BT blaze
Placed metal sign with bearing and distance information on each BT (54-3)
Placed metal ATTENTION sign on each BT (54-4)
Placed 6 ft. metal guard post at corner with metal PROPERTY BOUNDARY sign and metal ATTENTION sign (54-2 and 54-4)
I measured to the centerline of each bearing tree using tape and hand compass with declination set at 20 degrees east.

REGISTERED
PROFESSIONAL
LAND SURVEYOR
Edwin A. Stryker
OREGON
JULY 15, 1983
EDWIN A. STRYKER
2060

Office of..... County of.....
State of....., I hereby certify that the within instrument was filed in this office
for record on the..... day of....., 19.....
..... by
(COUNTY OFFICIAL) (DEPUTY)