


CERTIFIED RECORD OF LAND CORNER MONUMENTATION

INDEX MS 813

History of original corner establishment:

SHEET 2 - HIST. CONT.

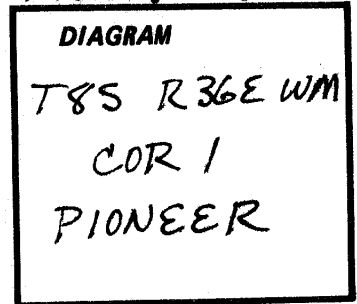

whence, the cor. common to Secs. 34-35, T8S, and Secs. 2-3, T9S, R36E, WM, bears S89-18W, 703.61 feet.
 The original bearing tree of Sur. No. 485, Gold Hill lode, bears N59-25E, 13.42 ft., blazed and scribed BT GH 3 485, and which I scribed
 1 813 PIONEER BT
 A red fir 10 ins. dia. bears N78-25E, 15.45 ft., blazed and scribed
 1 813 PIONEER BT

Description of corner evidence found:

Description of monument and accessories I established to perpetuate the original location of this corner:

REGISTERED PROFESSIONAL LAND SURVEYOR

Edwin A. Stryker

OREGON JULY 15, 1983 EDWIN A. STRYKER 2060

Office of..... County of.....
 State of....., I hereby certify that the within instrument was filed in this office
 for record on the..... day of....., 19.....
 by
 (COUNTY OFFICIAL) (DEPUTY)

FILED 11-16-1990
 BAKER COUNTY SURVEYOR
 SURVEY NO. B-36-59