

**CERTIFIED RECORD OF LAND CORNER MONUMENTATION**


**History of original corner establishment:**

Corner originally established by C.M.Foster under Mineral Survey No.129 (Later renumbered MS 77) and dated July 16, 1885.

Original notes state:  
A post marked S.A.H. No. 1 - 129.

Corner later used by Arthur Philbrick under Mineral Survey No.481 and dated July 11,1902.

Original notes state: Identical with Cor.No.1, Mammoth Lode, M.S.-129. A granite stone, 24x6x4 ins.at top and 12 ins.at base, set 12 ins.in the ground, with mound of rocks along side, chiseled M.1-129-B.B.5-481, whence The N.E.Cor.Sec.2 T.9 S.R.36 E.W.M. bears S32°40'E.1716 feet. Cor.No.2, Luxemburg Lode, M.S.428, also Cor.No.2, Alta Lode, M.S.427, bears N.47°01'E.263 ft. A black pine 4 ins.diam., bears S.60°25'E, 68.71 ft. A spruce, 5 ins.diam., bears S81°W, 222.77 ft., each blazed and scribed B.T.M.1-129-B.B.5-481.

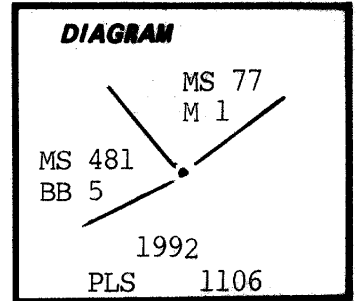

**Description of corner evidence found:**

No trace of original stone.

A 22" white fir brs S80°04'W, 222.77' to face and 223.1' to center of tree with scribes visible after opening blaze (Original BT.-MS No.481) (Original notes call for a spruce).

**Description of monument and accessories established to perpetuate the original location of this corner:**

The corner area has been disturbed by a road. Re-established corner by calculating distance/distance intersection from the face of the found BT and from alta Corner 2, using record distances reported in MS 481.

At re-established corner position...

Set a 5/8" x 18" iron pin with bottom driven 5" into rock. The iron pin is capped with a 1 1/2" aluminum cap. This monument was set because corner point falls near an old road bed which is occasionally used. The top of the monument is 8" below the road bed.

New bearing trees established:

- A 20" western larch brs N65 1/2°W, 48.4' scribed 1-M-77/5-BB-481 BT.
- A 12" lodgepole pine brs N29 1/2°E, 8.0' scribed 1-M-77/5-BB-481 BT.

New bearing trees have a brass washer stamped PLS 1106 nailed to face of blaze. Attached sign 54-3 & 54-4 and painted face of blaze & 6" red band around each BT. Set steel fence post N46°E, 4.2' from corner point with sign 54-2 & 54-9 attached.

Compass declination 18° East.

I hereby certify that the above corner was properly re-established by me to U.S.F.S. standards on September 10, 1992.

REGISTERED  
PROFESSIONAL  
LAND SURVEYOR

*William R. Wells*

OREGON  
JULY 22, 1977  
WILLIAM R. WELLS  
1106

Office of... County Surveyor... County of... Baker  
State of... Oregon... , I hereby certify that the within instrument was filed in this office  
for record on the... day of... , 19....  
..... by .....  
(COUNTY OFFICIAL) (DEPUTY)

FILED 3-24-93  
BAKER COUNTY SURVEYOR  
SURVEY NO. 8-36-63