


CERTIFIED RECORD OF LAND CORNER MONUMENTATION

History of original corner establishment:

Corner originally established by C.M.Foster under Mineral Survey No.129 (Later renumbered MS 77) and dated July 16,1885.

Original notes state:

A post marked S.A.H.No.2-129.

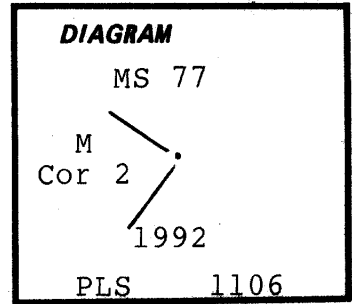

Cor.2 Mammoth

Description of corner evidence found:

The corner area has burnt since corner established in 1885, some traces of charcoal were found in corner area.

Description of monument and accessories established to perpetuate the original location of this corner:

The corner position was re-established by using the tie from Casaubon Cor.1, deflecting record angle from Casaubon line 2-1, and measuring record distance from Casaubon Cor.1. At position established from Casaubon Cor.1...

Set a 2½"x30" aluminum pipe with 2½" aluminum cap 28" in ground and surrounded with mound of earth & stone. Cap marked as shown in corner diagram.

New bearing trees established:

- A 11" western larch brs S15°E, 25.3' scribed 2-M-77 BT.
- A 13" lodgepole pine brs N80½°E, 50.7' scribed 2-M-77 BT.

New bearing trees have a brass washer stamped PLS 1106 nailed to face of blaze. Attached sign 54-3 & 54-9 and painted face of blaze & 6" red band around each BT. Set steel fence post on National Forest Boundary SW of corner & attached sign 54-2 & 54-9.

Compass declination 18° East.

I hereby certify that the above corner was properly re-established by me to U.S.F.S. standards on September 17,1992.

REGISTERED
PROFESSIONAL
LAND SURVEYOR

William R. Wells

OREGON
JULY 22, 1977
WILLIAM R. WELLS
1106

Office of..... County Surveyor..... County of..... Baker.....
State of..... Oregon....., I hereby certify that the within instrument was filed in this office
for record on the..... day of....., 19.....
..... by
(COUNTY OFFICIAL) (DEPUTY)