


CERTIFIED RECORD OF LAND CORNER MONUMENTATION

**History of original corner establishment:**

Corner originally established by C.M.Foster under Mineral Survey No.129 (Later renumbered MS 77) and dated July 16,1885.

Original notes state:

A post marked S.A.H.No.3-129.

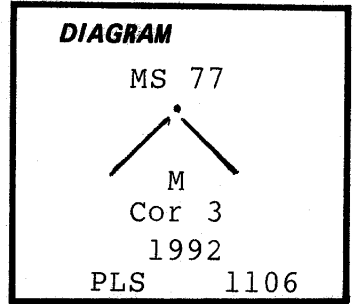

Cor. 3 Mammoth

**Description of corner evidence found:**

The corner area has burnt since corner establishment in 1885, and a few charcoal fragments were found below ground in the corner area.

**Description of monument and accessories I established to perpetuate the original location of this corner:**

The corner position was re-established by using the tie from Casaubon Cor.6, deflecting record angle from Casaubon Line 5-6, and measuring record distance from Casaubon Cor.6. At position established from Casaubon Cor.6...

Set a 2 1/2"x30" aluminum pipe with 2 1/2" aluminum cap 28" in ground and surrounded with mound of earth & stone. Cap marked as shown in corner diagram.

New bearing trees established:

A 10" western larch brs N17°E, 35.4' scribed 3-M-77 BT.

A 10" western larch brs S87°W, 33.8' scribed 3-M-77 BT.

New bearing trees have a brass washer stamped PLS 1106 nailed to face of blaze. Attached sign 54-3 & 54-9 and painted face of blaze & 6" red band around each BT. Set steel fence post SE of corner on claim line and attached sign 54-9.

Compass declination 18° East.

I hereby certify that the above corner was properly re-established by me to U.S.F.S. standards on September 17,1992.

REGISTERED  
PROFESSIONAL  
LAND SURVEYOR

*William R. Wells*

OREGON  
JULY 23, 1977  
WILLIAM R. WELLS  
1106

Office of.....County Surveyor..... County of... Baker.....

State of..... Oregon....., I hereby certify that the within instrument was filed in this office

for record on the..... day of....., 19.....

..... by .....

(COUNTY OFFICIAL)

(DEPUTY)