


CERTIFIED RECORD OF LAND CORNER MONUMENTATION

**History of original corner establishment:**

None. Corner established as part of this survey.

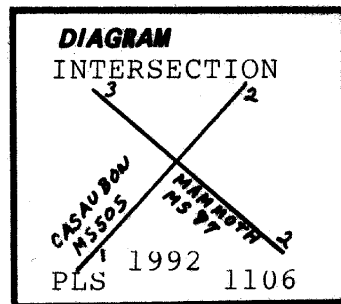

INTERSECTION

**Description of corner evidence found:**

None.

**Description of monument and accessories | established to perpetuate the original location of this corner:**

At position determined by survey...

Set 2½" x 30" aluminum pipe with 2½" aluminum cap 28" in ground and surrounded with a mound of earth and stone. Cap marked as shown in corner diagram.

New bearing trees established:

A 7" western larch brs S08°W, 5.3' scribed INTEX-M-77/C-505 BT.

A 10" western larch brs S75½°W, 28.0' scribed INTEX-M-77/C-505 BT.

New bearing trees have a brass washer stamped PLS 1106 nailed to face of blaze. Attached sign 54-3 & 54-9 to each BT & painted face of blaze & 6" red band around each BT. Set steel fence post on National Forest Boundary NE of corner with sign 54-2 & 54-9 attached.

Compass declination 18° East.

I hereby certify that the above corner was properly established by me to U.S.F.S. standards on September 17, 1992.

REGISTERED  
PROFESSIONAL  
LAND SURVEYOR

*William R. Wells*

OREGON  
JULY 22, 1977  
WILLIAM R. WELLS  
1106

Office of...County Surveyor..... County of Baker.....  
State of Oregon....., I hereby certify that the within instrument was filed in this office  
for record on the..... day of....., 19.....

..... by .....  
(COUNTY OFFICIAL) (DEPUTY)

FILED 3-24-93  
BAKER COUNTY SURVEYOR  
SURVEY NO. 8-36-67