


CERTIFIED RECORD OF LAND CORNER MONUMENTATION

History of original corner establishment:

Corner originally established by John Hagel under Mineral Survey No.427 and surveyed under instructions dated July 8, 1901.

Original notes state: Identical with corner No.1 of the Luxemburg Quartz Claim, Survey 428. Set a white pine post 4 ins.square, 4½ ft.long.18 ins.in the ground with a mound of earth around it, scribed Alta Q.Cl.C. 1-427. The southwest loc. Cor.bears S.38°49'E,95.0 ft. A black pine tree 6 ins.diam.bears N.45°45'W,74.5 ft. A black pine tree 6 ins.diam.bears N.32°15'W,73.0 ft.: Luxemburg Cor.1 both blazed and scribed Alta Q.Cl.,C.1-427-BT.

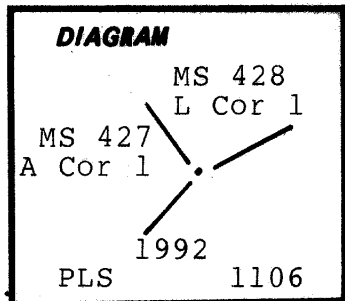

Corner established by John Hagel under Mineral Survey No.428 and dated July 10,1901. His notes state: Identical with Corner No.1 of the "Alta" Quartz Claim. A white fir post 4 ins.square,3 ft. above the ground,with a mound of earth around it, scribed Alta C.1-427. Scribed it Lux.C.1-428. A black pine tree

Description of corner evidence found: 6 ins.diam.bears S.72°30'E,39.1 ft: A black pine tree 4 ins.diam.bears N.60°W,31.0 ft: both blazed and scribed Lux.C.1-428-B.T.

Found a post hole with rotted post remains at and below ground surface, from which...

A 10" down lodgepole pine brs N32¼°W, 73' ± to root hole with scribes visible on opened blaze.(Original BT)

Description of monument and accessories I established to perpetuate the original location of this corner:

At position of found post remains, from which...

Set 2½" x 30" aluminum pipe with 2½" aluminum cap 28" in ground and surrounded with a mound of earth and stone. Cap marked as shown in corner diagram.

New bearing trees established:

A 12" western larch brs S30½°E, 82.2' scribed 1-A-427/1-L-428 BT.
A 11" lodgepole pine brs N71½°W, 36.5' scribed 1-A-427/1-L-428 BT.

New bearing trees have a brass washer stamped PLS 1106 nailed to face of blaze.Attached sign 54-3 & 54-9 to each BT & painted face of blaze & 6" red band around each BT. Set steel fence post on National Forest Boundary NE of corner with sign 54-2 & 54-9 attached.

Compass declination 18° East.

I hereby certify that the above corner was properly remonumented by me to U.S.F.S. standards on September 10, 1992.

REGISTERED
PROFESSIONAL
LAND SURVEYOR

William R. Wells

OREGON
JULY 22, 1977
WILLIAM R. WELLS
1106

Office of... County Surveyor..... County of Baker.....
Oregon
State of....., I hereby certify that the within instrument was filed in this office
for record on the..... day of....., 19.....
..... by

(COUNTY OFFICIAL)

(DEPUTY)

FILED 3-24-93
BAKER COUNTY SURVEYOR
SURVEY NO. 8-36-68