


CERTIFIED RECORD OF LAND CORNER MONUMENTATION

History of original corner establishment:

Corner originally established by John Hagel under Mineral Survey No.427 and surveyed under instructions dated July 8,1901. Original notes state: Identical with cor.2 of the "Luxemburg" Quartz Claim.Sur.428. Set a black pine post 5 ins.square, 4½ ft. long,18 ins in the ground with a mound of earth around it, scribed Alta Q.Cl.C.2-427. A spruce tree 5 ins.diam.bears S.34° 15'E,9.8 ft. A black pine tree 12 ins.diam.bears S.78° E, 11.8 ft.: both blazed and scribed Alta Q.Cl.C.2-427 BT.
Corner established by John Hagel under Mineral Survey No.428 and dated July 10,1901. His notes state: Identical with the Corner No.2 of the "Alta" Quartz Claim, survey, 427. A black pine post 5 ins.square, 3 ft. above the ground, with a mound of earth around it, scribed Alta Q.Cl.C.2-427. Scribed it Lux. Q.Cl.C.2-428.

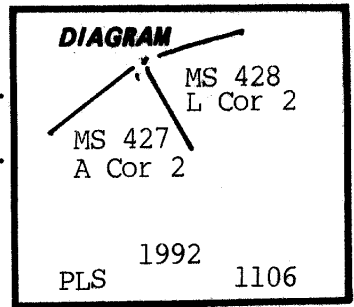

Alta Cor.2
Luxemburg Cor. 2

Description of corner evidence found:

Found rotted remains of post below ground level, from which...
A 38" spruce brs S34¼°E, 9.8' with healed blaze.(Original BT)
A 18" lodgepole pine brs S78°E, 11.7' with scribes visible on previously opened blaze.(Original BT)

Description of monument and accessories I established to perpetuate the original location of this corner:

At position of found post remains...

Set 2½" x 30" aluminum pipe with 2½" aluminum cap 28" in ground and surrounded with a mound of earth and stone. Cap marked as shown in corner diagram.

New bearing trees established:

A 22" western larch brs N58°W, 49.9' scribed 2-A-427/2-L-428 BT.
A 17" western larch brs S63½°W, 45.0' scribed 2-A-427/2-L-428 BT.

New bearing trees have a brass washer stamped PLS 1106 nailed to face of blaze.Attached sign 54-3 & 54-9 to each BT & painted face of blaze & 6" red band around each BT. Set steel fence post on National Forest Boundary SW of corner with sign 54-2 & 54-9 attached.

Compass declination 18° East.

I hereby certify that the above corner was properly remonumented by me to U.S.F.S. standards on September 15, 1992.

REGISTERED
PROFESSIONAL
LAND SURVEYOR

William R. Wells

OREGON
JULY 22, 1977
WILLIAM R. WELLS
1106

Office of... County Surveyor..... County of... Baker
Oregon
State of....., I hereby certify that the within instrument was filed in this office
for record on the..... day of....., 19.....
..... by

(COUNTY OFFICIAL)

(DEPUTY)

FILED 3-24-93
BAKER COUNTY SURVEYOR
SURVEY NO. 8-36-69