

CERTIFIED RECORD OF LAND CORNER MONUMENTATION


History of original corner establishment:

Corner originally established by John Hagel under Mineral Survey No.427 and surveyed under instructions dated July 8, 1901.

Original notes state:

Set a black pine post 4 ins.square, 4½ ft. long, 18 ins. in the ground, with a mound of earth around it, scribed Alta Q.Cl.,C.5-427.

A black pine tree, 6 ins.diam.bears N.81°30'E., 4.2 ft.
A black pine tree, 7 ins.diam.bears S.70°W., 7.6 ft:
both blazed and scribed Alta Q.Cl.,C.5-427-B.T.

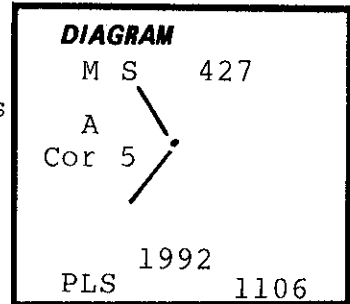

Description of corner evidence found:

Found rotted post remains at ground level, from which...

A 11" dead standing lodgepole pine brs N81½°E, 4.3' with scribes visible on partially healed blaze.(Original BT)

A 14" lodgepole pine brs S70°W, 7.5' with healed blaze. (Original BT)

Description of monument and accessories | established to perpetuate the original location of this corner:

At position of found post remains...

Set 2½" x 30" aluminum pipe with 2½" aluminum cap 26" in ground and surrounded with a mound of earth and stone. Cap marked as shown in corner diagram. Placed remains of original post on new mound.

New bearing trees established:

A 9" western larch brs S29½°E, 41.0' scribed 5-A-427 BT.

A 11" western larch brs S63½°E, 49.9' scribed 5-A-427 BT.

New bearing trees have a brass washer stamped PLS 1106 nailed to face of blaze.Attached sign 54-3 & 54-9 to each BT & painted face of blaze & 6" red band around each BT. Set steel fence post on National Forest Boundary SW of corner with sign 54-2 & 54-9 attached.

Compass declination 18° East.

I hereby certify that the above corner was properly remonumented by me to U.S.F.S. standards on September 11, 1992.

REGISTERED
PROFESSIONAL
LAND SURVEYOR

William R Wells

OREGON
JULY 22, 1977
WILLIAM R. WELLS
1106

Office of...County Surveyor..... County of...Baker.....
State of...Oregon....., I hereby certify that the within instrument was filed in this office
for record on the..... day of....., 19.....

..... by
(COUNTY OFFICIAL) (DEPUTY)

FILED 3-24-93
BAKER COUNTY SURVEYOR
SURVEY NO. 8-36-72