

CERTIFIED RECORD OF LAND CORNER MONUMENTATION


History of original corner establishment:

Corner originally established by John Hagel under Mineral Survey No.427 and surveyed under instructions dated July 8, 1901.

Original notes state:

Set a black pine post 4 ins.square, 4½ ft. long, 18 ins.in the ground, with a mound of earth around it, scribed Alta Q.Cl.,C.6-427.

A black pine tree 6 ins.diam.bears S.48°E.,16.1 ft.
A black pine tree 10 ins.diam.bears N.14°40'E, 18.2 ft.:
both blazed and scribed Alta Q.Cl.,C.6-427-BT.

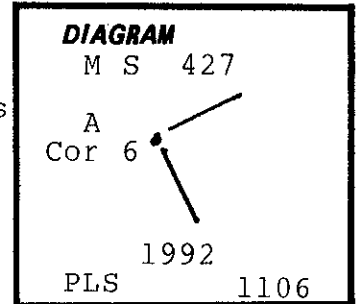

Cor.6 Alta

Description of corner evidence found:

Found rotted remains of post below ground level, from which...

A 12" dead lodgepole pine brs S45½°E, 16.1' with healed blaze.(Original BT)

A 17" uprooted lodgepole pine brs N14 ¾°E, 18.2' †to root hole with healed blaze.(Original BT)

Description of monument and accessories | established to perpetuate the original location of this corner:

At position of found post remains...

Set 2½" x 30" aluminum pipe with 2½" aluminum cap 26" in ground and surrounded with a mound of earth and stone. Cap marked as shown in corner diagram.

New bearing trees established:

A 14" western larch brs N60½°W, 48.0' scribed 6-A-427 BT.

A 15" western larch brs N21½°W, 90.5' scribed 6-A-427 BT.

New bearing trees have a brass washer stamped PLS 1106 nailed to face of blaze.Attached sign 54-3 & 54-9 to each BT & painted face of blaze & 6" red band around each BT. Set steel fence post on National Forest Boundary NE of corner with sign 54-2 & 54-9 attached.

Compass declination 18° East.

I hereby certify that the above corner was properly remonumented by me to U.S.F.S. standards on September 11, 1992.

REGISTERED
PROFESSIONAL
LAND SURVEYOR

Will-R. Wells

OREGON
JULY 22, 1977
WILLIAM R. WELLS
1106

Office of...County...Surveyor..... County of...Baker.....
State of...Oregon....., I hereby certify that the within instrument was filed in this office
for record on the..... day of....., 19.....

..... by
(COUNTY OFFICIAL) (DEPUTY)