

CERTIFIED RECORD OF LAND CORNER MONUMENTATION


History of original corner establishment:

Corner originally established by John Hagel under Mineral Survey No.427 and surveyed under instructions dated July 8, 1901.

Original notes state:

Set a black pine post 4 ins.square, 4½ ft. long. 18 ins. in the ground, with a mound of earth around it, scribed Alta Q.Cl.,C. 7-427.

A black pine tree, 7 ins.diam.bears N32°40'W,31.0 ft.
A black pine tree 6 ins.diam.bears N54°15'W,31.4 ft:
both blazed and scribed Alta Q.Cl.,C. 7-427-B.T.

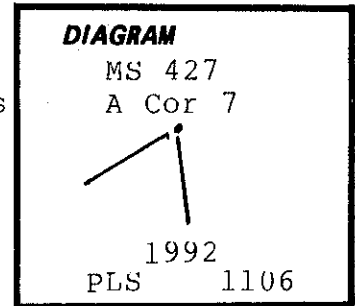

Cor. 7 Alta

Description of corner evidence found:

Found rotten remains of original post in place below ground surface, from which...

A 10" dia lodgepole pine brs N54 1/4°W, 31.4' ± to root hole with visible scribes on partially healed blaze. (Original BT)

Description of monument and accessories | established to perpetuate the original location of this corner:

At position of remains of original found post...

Set 2½" x 30" aluminum pipe with 2½" aluminum cap 28" in ground and surrounded with a mound of earth only. Cap marked as shown in corner diagram.

New bearing trees established:

A 11" western larch brs N82½°W, 44.4; scribed 7-A-427 BT.
A 10½" lodgepole pine brs N14 3/4°E, 71.5' scribed 7-A-427 BT.

New bearing trees have a brass washer stamped PLS 1106 nailed to face of blaze.Attached sign 54-3 & 54-9 to each BT & painted face of blaze & 6" red band around each BT. Set steel fence post on National Forest Boundary SE of corner with sign 54-2 & 54-9 attached.

Compass declination 18° East.

I hereby certify that the above corner was properly remonumented by me on U.S.F.S. standards on September 09,1992.

REGISTERED
PROFESSIONAL
LAND SURVEYOR

William R. Wells

OREGON
JULY 22, 1947
WILLIAM R. WELLS
1106

Office of County Surveyor County of Baker
State of Oregon , I hereby certify that the within instrument was filed in this office
for record on the..... day of..... , 19.....
..... by

(COUNTY OFFICIAL)

(DEPUTY)

FILED 8-36-24
BAKER COUNTY SURVEYOR
SURVEY NO. 8-36-74