

CERTIFIED RECORD OF LAND CORNER MONUMENTATION


History of original corner establishment:

Corner originally established by John Hagel under Mineral Survey No.427 and surveyed under instructions dated July 8, 1901.

Original notes state:

Set a white fir post 4 ins.square, 4½ ft. long 18 ins.in the ground, with a mound of earth around it, scribed Alta Q.Cl.,S.Cen-427.

A white fir tree 5 ins.diam.blazed and scribed Alta Q.Cl.,S.Cen. 427-B.T. bears S 2°W, 19.4 ft.

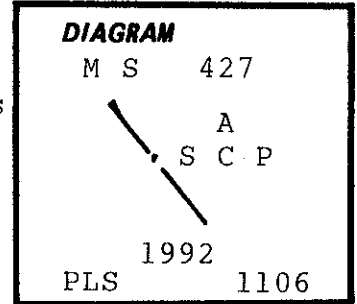

Alta South Center

Description of corner evidence found:

Note: There are some loose remains of a rotted wood post in the corner area but corner post location could not be determined.

A 9" dead, standing white fir brs S02°W, 19.4' to where blaze face stands and 19.6' to centerline with healed blaze.(Original BT)

Description of monument and accessories I established to perpetuate the original location of this corner:

Re-established corner by measuring N02°E, 19.4' from where blaze face is located, from which...

Set 2½" x 30" aluminum pipe with 2½" aluminum cap 28" in ground and surrounded with a mound of earth and stone. Cap marked as shown in corner diagram.

References: Trees in the area are all bug damaged white and douglas fir. For accessories, I marked 2 bearing objects, as follows:
A 20'x8'x10' out of ground granite rock brs N57½°W, 17.1' mkd "XBO" on South face, 2½' above ground.
A 14'x8'x5' out of ground granite rock brs S31½°W, 14.7' mkd "XBO" on East face, 1' above ground.

Painted chisel marks with red paint and placed 54-3 & 54-9 signs near bearing objects. Measured to the "X" on the bearing object markings. Set steel fence post on National Forest Boundary NW of corner and attached sign 54-2 & 54-9.

Compass declination 18° East.

I hereby certify that the above corner was properly re-established by me to U.S.F.S. standards on September 15, 1992.

REGISTERED
PROFESSIONAL
LAND SURVEYOR

William R. Wells

OREGON
JULY 22, 1977
WILLIAM R. WELLS
1106

Office of...County...Surveyor..... County of...Baker.....
State of...Oregon....., I hereby certify that the within instrument was filed in this office
for record on the..... day of....., 19.....

..... by
(COUNTY OFFICIAL) (DEPUTY)

FILED 3-24-93
BAKER COUNTY SURVEYOR
SURVEY NO. 8-36-76