

CERTIFIED RECORD OF LAND CORNER MONUMENTATION


History of original corner establishment:

Corner originally established by John Hagel under Mineral Survey No.428 and surveyed under instructions dated July 11,1901.

Original notes state:

Set a black pine post 4 ins.square, 4½ ft.long. 18 ins.in the ground, with a mound of earth around it, scribed Lux.Q.Cl.,C.3-428.

The north west location corner bears N13°E, 15.0 ft.
A spruce tree 8 ins.diam.bears N.47°10'W, 15.3 ft.
A black pine tree 11 ins.diam.bears S.84°30'W, 16.3 ft.:
both blazed and scribed Lux.C.3-428-B.T.

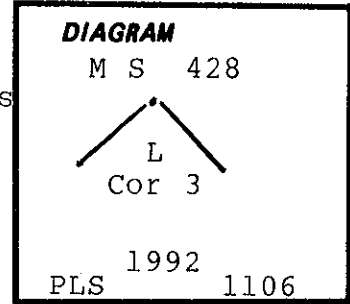

Cor.3 Luxemburg

Description of corner evidence found:

Found rotted post remains in mound of stone from which...

A 10" down rotted spruce brs N47¼°W, 15.3' to root hole with visible scribes. (Original BT)

A 10" down lodgepole pine brs S84½°W, 16.3' ± with scribes visible on open blaze.(Original BT)

Description of monument and accessories I established to perpetuate the original location of this corner:

At position of found post remains...

Set 2½" x 30" aluminum pipe with 2½" aluminum cap 24" in ground and surrounded with a mound of earth and stone. Cap marked as shown in corner diagram. Placed original post remains on mound.

New bearing trees established:

A 9" western larch brs N13°W, 38.9' scribed 3-L-428 BT.

A 21" western larch brs S62½°E, 26.8' scribed 3-L-428 BT.

New bearing trees have a brass washer stamped PLS 1106 nailed to face of blaze.Attached sign 54-3 & 54-9 to each BT & painted face of blaze & 6" red band around each BT. Set steel fence post on National Forest Boundary SW of corner with sign 54-2 & 54-9 attached.

Compass declination 18° East.

I hereby certify that the above corner was properly remonumented by me to U.S.F.S. standards on September 11, 1992.

REGISTERED
PROFESSIONAL
LAND SURVEYOR

William R. Wells

OREGON
JULY 22, 1977
WILLIAM R. WELLS
1106

Office of.....County Surveyor..... County of.....Baker.....

State of.....Oregon....., I hereby certify that the within instrument was filed in this office

for record on the..... day of....., 19.....

..... by
(COUNTY OFFICIAL) (DEPUTY)