

CERTIFIED RECORD OF LAND CORNER MONUMENTATION


History of original corner establishment:

Corner originally established by John Hagel under Mineral Survey No.428 and surveyed under instructions dated July 11,1901.

Original notes state:

Set a tamarack post 4 ins.square, 5 ft.long. 24 ins. in the ground, with a mound of earth and rocks around it, scribed Lux.Q.Cl.,C.4-428.

The north east location corner bears N57°E, 40.0 ft. Cor.4 Luxemburg
A tamarack tree 12 ins.diam.bears N46°W, 41.4 ft.
A tamarack tree 12 ins.diam.bears N28°45'W, 45.0 ft.:
both blazed and scribed Lux.C.4-428-B.T.

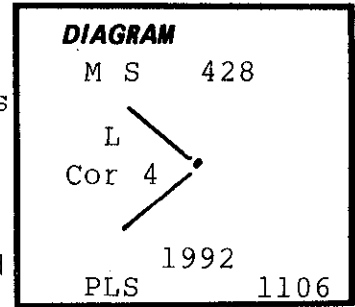

Description of corner evidence found:

Found rotten remains of post in mound of stone, from which...

A 14" western larch brs N42°W, 40.5' with healed blaze.(Original BT)

A 17" western larch brs N25½°W, 44.6' with healed blaze.(Original BT)

Description of monument and accessories I established to perpetuate the original location of this corner:

At position of found post remains...

Set 2½" x 30" aluminum pipe with 2½" aluminum cap 26" in ground and surrounded with a mound of earth and stone. Cap marked as shown in corner diagram.

Original bearing trees are in excellent shape.

Attached sign 54-3 and 54-9 and painted face of blaze and a 6" red band around each BT. Set steel fence post NW of corner on National Forest Boundary and attached sign 54-2 and 54-9.

Compass declination 18° East.

I hereby certify that the above corner was properly remonumented by me to U.S.F.S. standards on September 11, 1992.

REGISTERED
PROFESSIONAL
LAND SURVEYOR

William R. Wells

OREGON
JULY 22, 1987
WILLIAM R. WELLS
1106

Office of...County Surveyor..... County of...Baker.....
State of...Oregon....., I hereby certify that the within instrument was filed in this office
for record on the..... day of....., 19.....
..... by
(COUNTY OFFICIAL) (DEPUTY)