

CERTIFIED RECORD OF LAND CORNER MONUMENTATION

History of original corner establishment:


Corner originally established by Arthur Philbrick under Mineral Survey No.481 and dated July 11, 1902.

Original notes state:

A black pine post, 4 ft.long,4 ins.square,set 12 ins. in the ground,with mound of earth, scribed B.B.1-R.F. 5-481,whence

A red fir,12 ins.diam,bears S77°30'W, 54.57 ft.

A red fir,4 ft.diam.bears S24°W, 42.34 ft.,each scribed B.T.B.B.1-R.F.5-481.

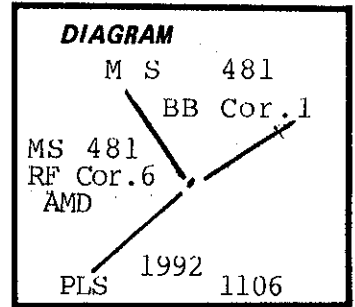

Cor.6 RED FOX
Cor.1 BELL BAKER

Corner amended by Arthur B.Browne under Mineral Survey No.481 and dated May 14,1904. Original notes state:

Scribing on post changed to read R.F.6-481, scribing on two bearing trees, as given in notes of original survey, also changed to read, B.T.R.F.6-481.

Description of corner evidence found:

No trace of original pine post.

A 40" dia. douglas fir stump brs S22°W 44.3' to centerline (42.34' to face) with X and nail visible.(Original BT)

A 31" dia.douglas fir stump brs S78½°W 55.1' to centerline (54.57' to face) with back cast and nail.(Original BT)

Description of monument and accessories established to perpetuate the original location of this corner:

Corner position reset by distance/distance intersection from original bearing tree faces, using record distances...

Set 2½" x 30" aluminum pipe with 2½" aluminum cap 24" in ground and surrounded with a mound of earth and stone. Cap marked as shown in corner diagram.

New bearing tree and bearing object established:

A 22" douglas fir brs S62½°E, 85.8' scribed 1-BB-481/6RF-481-AMD BT.

A 28" x 14" x 16" out of ground stone in place bears N74 3/4°E, 5.8', marked "XBO". Distance measured to "X".

New bearing tree has a brass washer stamped PLS 1106 nailed to face of blaze.Attached sign 54-3 & 54-9 to each BT & painted face of blaze & 6" red band around each BT. Set steel fence post on National Forest Boundary SW of corner with sign 54-2 & 54-9 attached.

Compass declination 18° East.

I hereby certify that the above corner was properly re-established by me to U.S.F.S. standards on September 10, 1992.

REGISTERED
PROFESSIONAL
LAND SURVEYOR

William R. Wells

OREGON
JULY 22, 1977
WILLIAM R. WELLS
1106

Office of.....County Surveyor..... County of.....Baker.....

State of.....Oregon....., I hereby certify that the within instrument was filed in this office

for record on the..... day of....., 19.....

..... by
(COUNTY OFFICIAL) (DEPUTY)